


T. 16 S., R. 3 W., W.M.

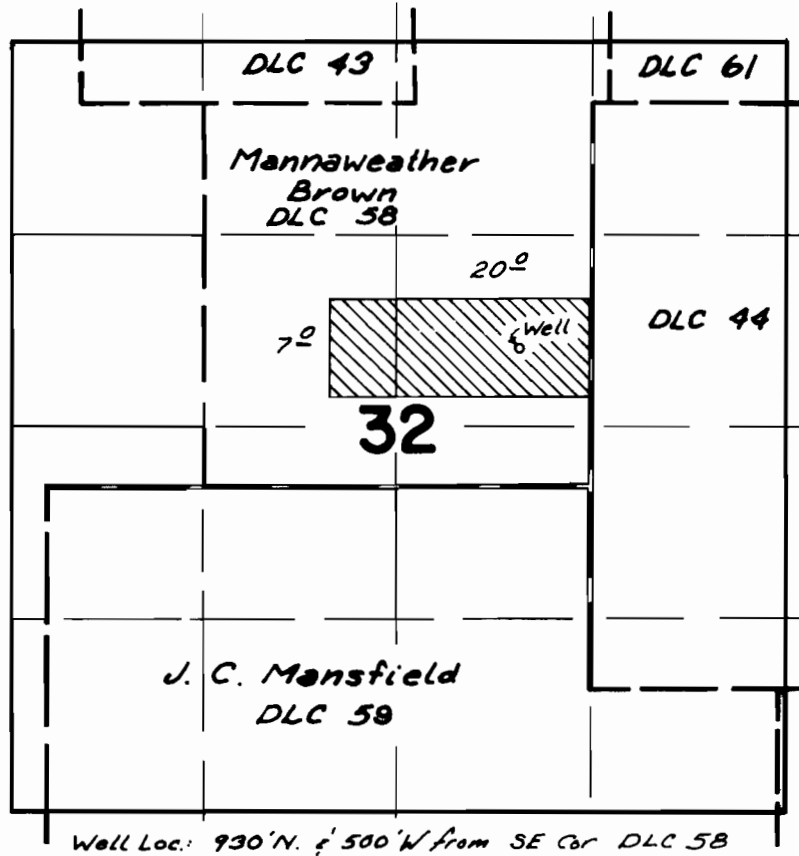

FINAL PROOF SURVEY UNDER

Application No. G-5815 Permit No. G-5569
IN NAME OF

Peter & Judy Ann Gutoski

Surveyed May 19, 1976, by D. M. Norby

DBA-1H-17 *dlb*