


T.19S.,R.5W.,W.M.

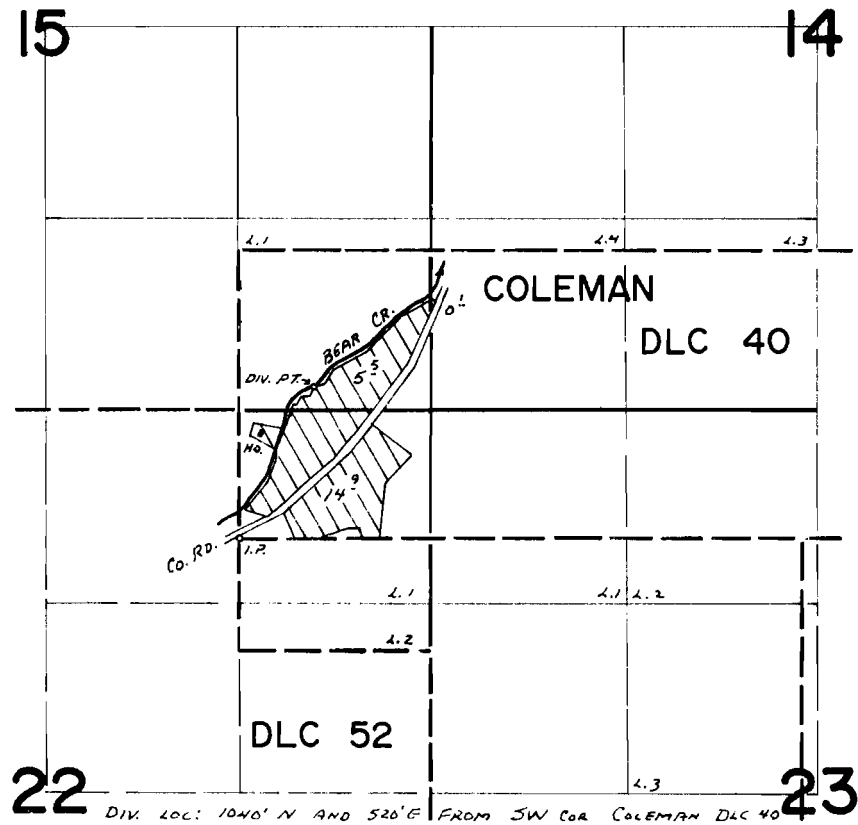

FINAL PROOF SURVEY

Transfer No. M-205

Applicant: ... Permit No. ...

IN NAME OF

ROBERT H. MATTSON

Surveyed APRIL 16 1975, by L. Toll