


# T.18&19S. R.2W.W.M.

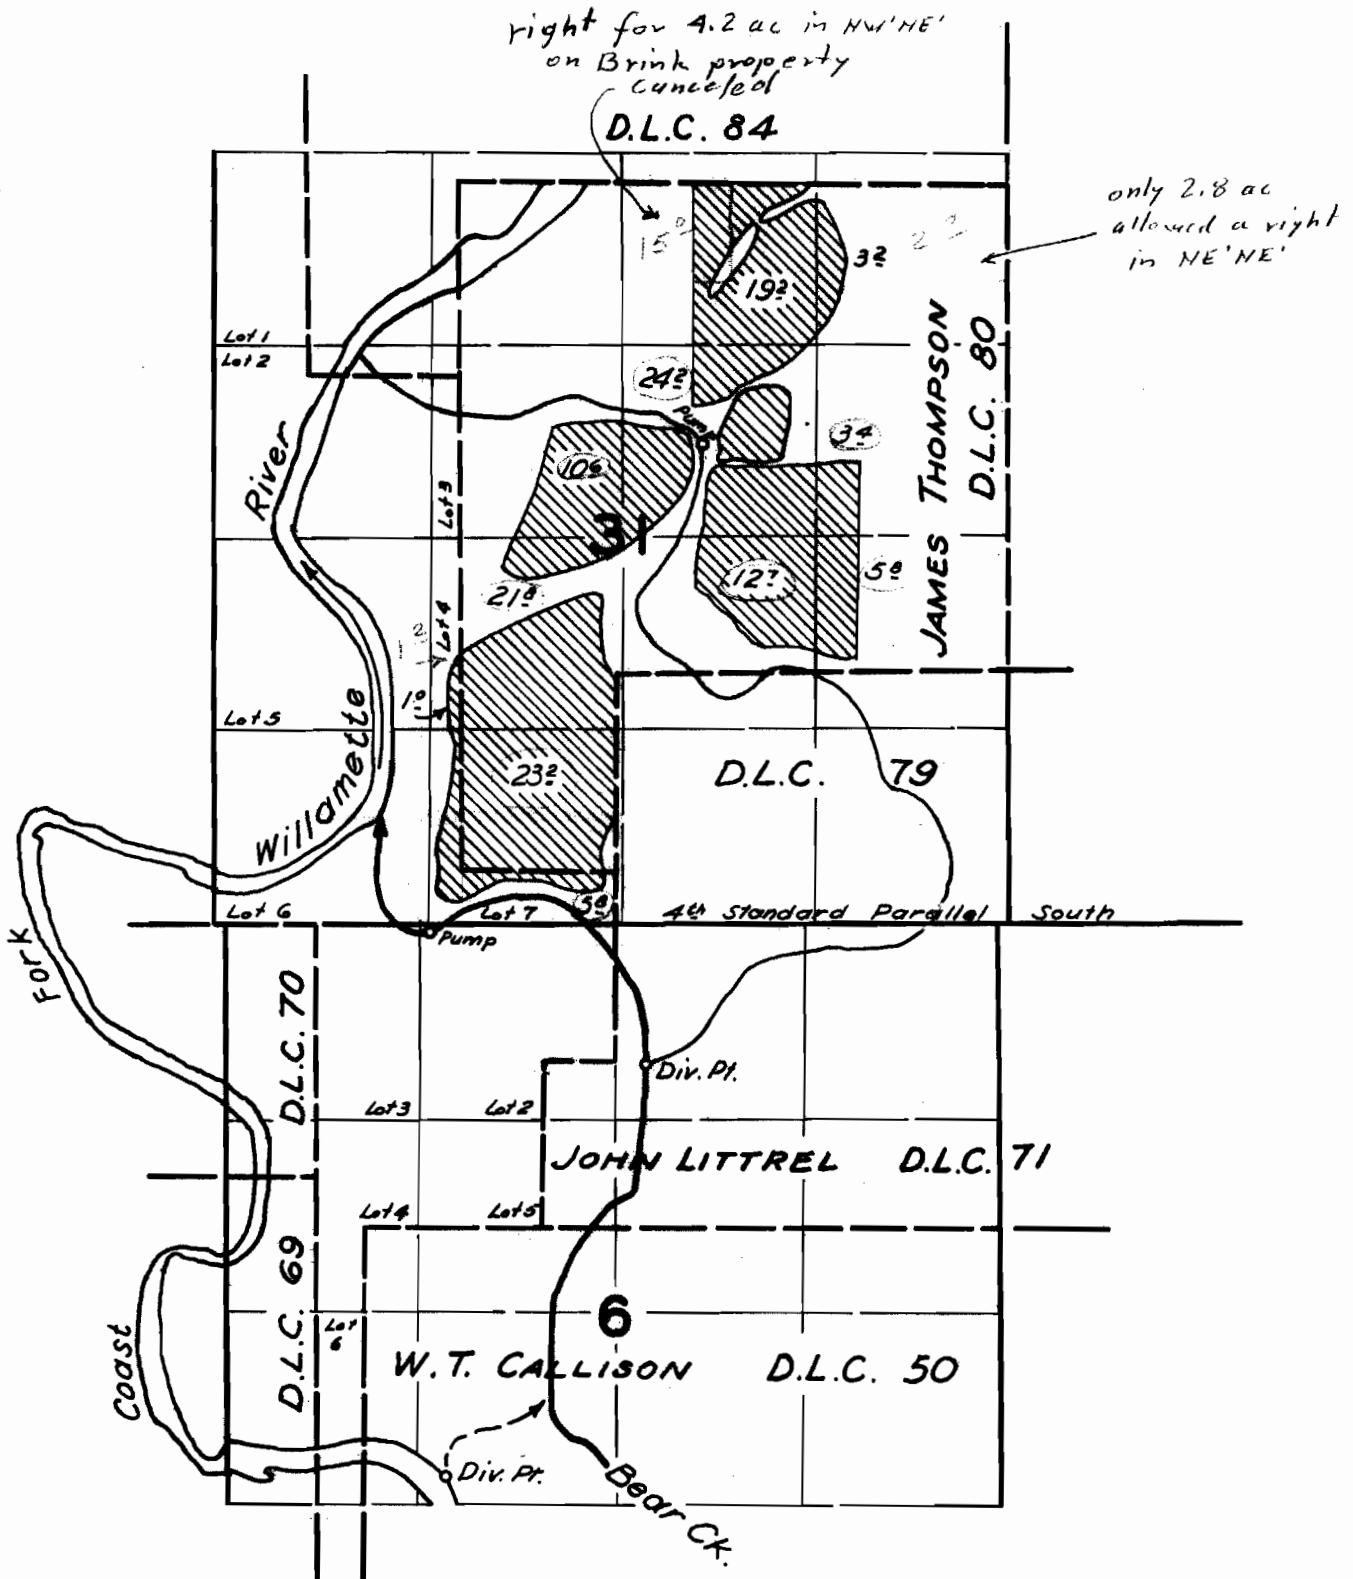

## FINAL PROOF SURVEY

UNDER

APPLICATION 30163 PERMIT 23565

IN NAME OF

JOHN V. & MOLLY CHASE NORTHAM

SURVEYED MAY 13 1960 BY R. JACKSON