


T.11&12S., R.4W., W.M.

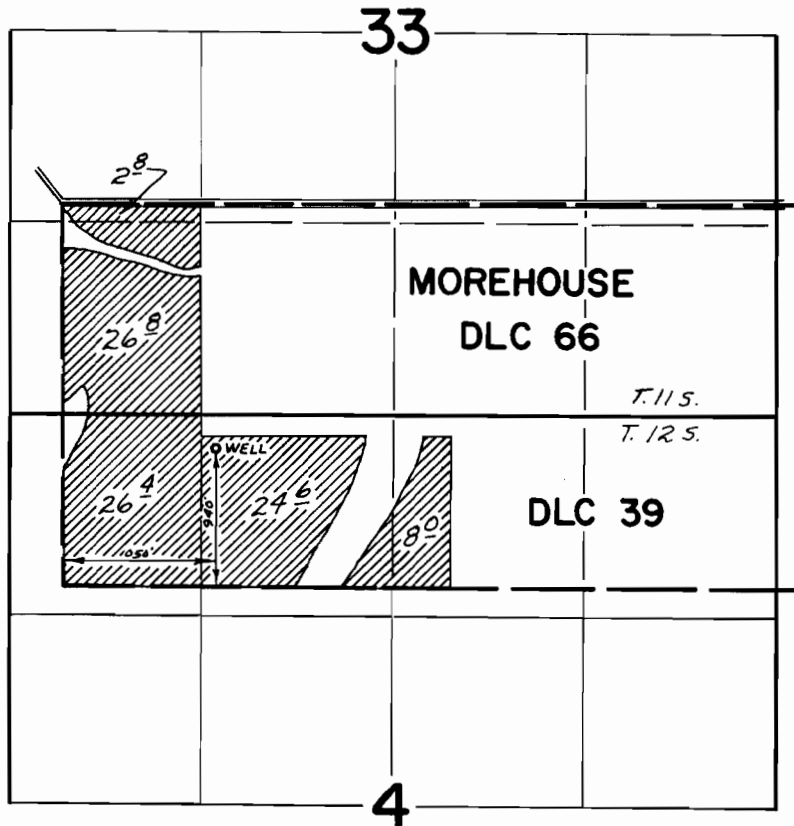

FINAL PROOF SURVEY
UNDER

Application No. G-4755 Permit No. G-4472
IN NAME OF

OAK KNOLL FARM

Surveyed May 29 1974, by D.M. Norby