


T.12S. R.1W.W.M.

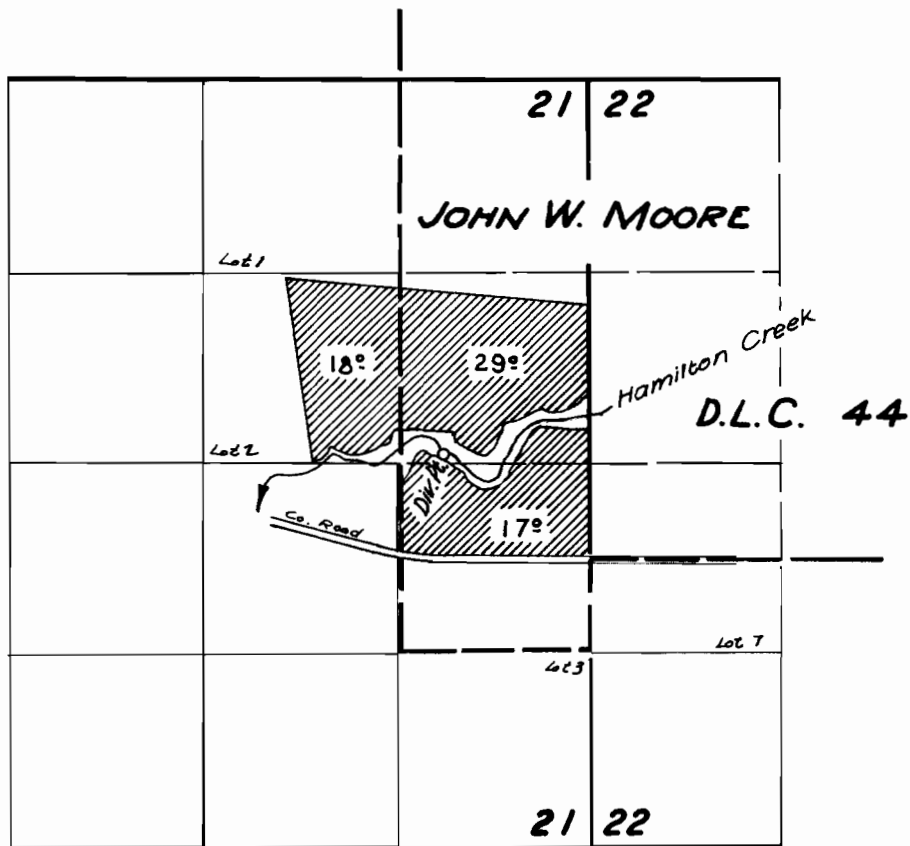

**FINAL PROOF SURVEY**  
UNDER

Application No. 26794 Permit No. 21049  
IN NAME OF

**WM. & HESTER MCPHERSON**

Surveyed 12 Sept. 1958, by C.Q. Bartels