


# T.13&14S.,R.4W.,W.M.

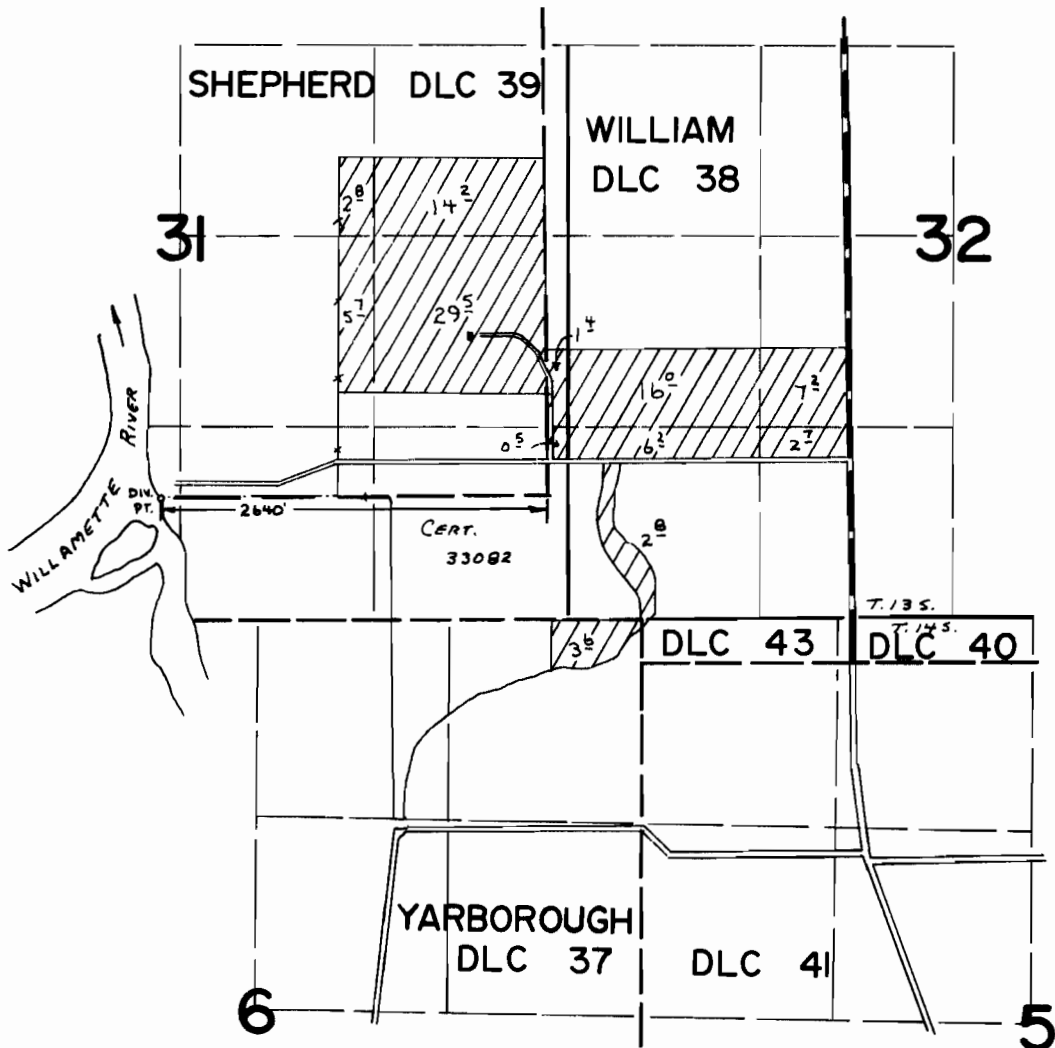

## FINAL PROOF SURVEY UNDER

Application No. 46120.. Permit No. 34456..  
IN NAME OF

.....DONALD L. BAYNE, JR. ....

Surveyed July 30 1975, by A. Tell .....