


T.17S. R.47E. W.M.

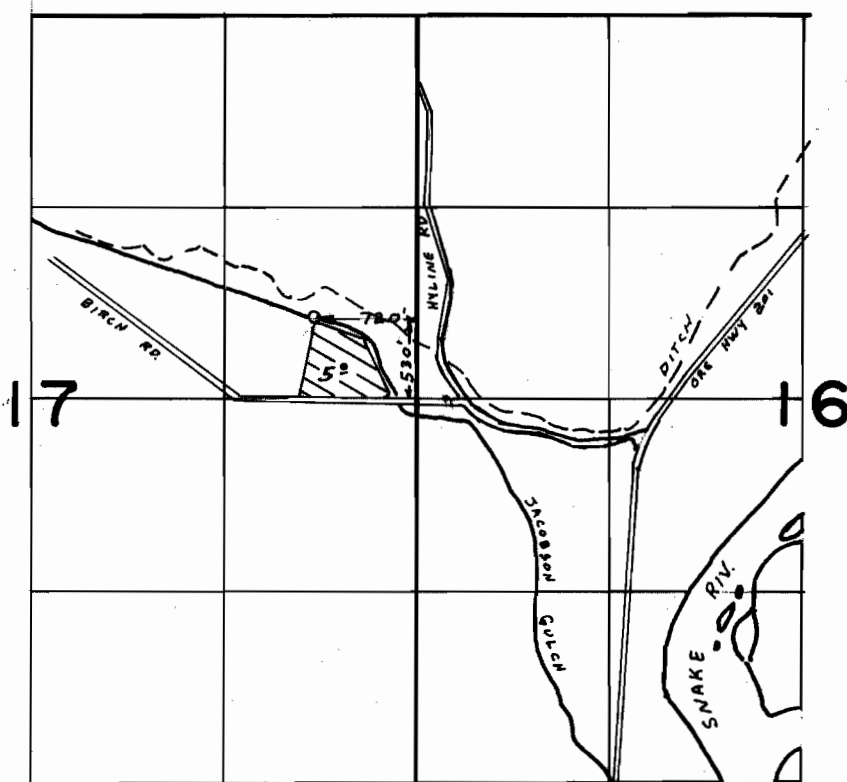

FINAL PROOF SURVEY
UNDER

Application No. 46957 Permit No. 37273
IN NAME OF

MERLE MAINE

Surveyed JUN 19 1974, by LH NUNN