


T.5&6S. R.I.W. W.M.

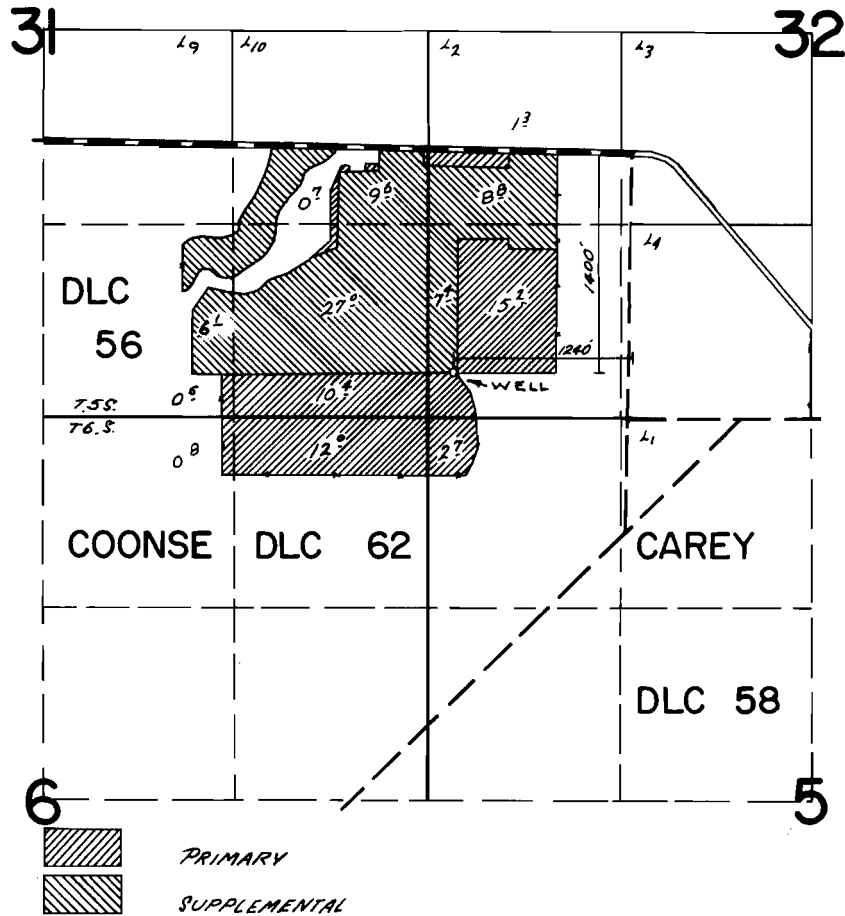

FINAL PROOF SURVEY UNDER

Application No. G-4501. Permit No. G-4243.
IN NAME OF

.....GEORGE KUSCHNICK.....

Surveyed April 9, 1974, by T. J. PAUL.....