


T.6S.,R.2W.,W.M.

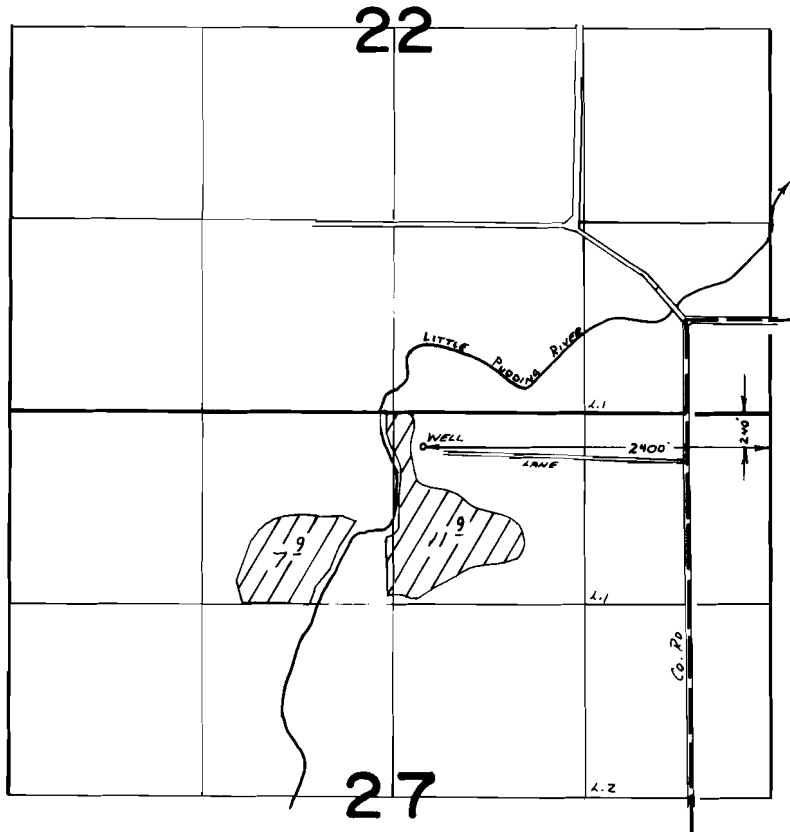

FINAL PROOF SURVEY
UNDER

Application No. G-5264 Permit No. G-5112
IN NAME OF

LESLIE F. KLAMPE

Surveyed SEPT. 3, 1974, by L. Toll