


T.6S.R.IE.W.M.

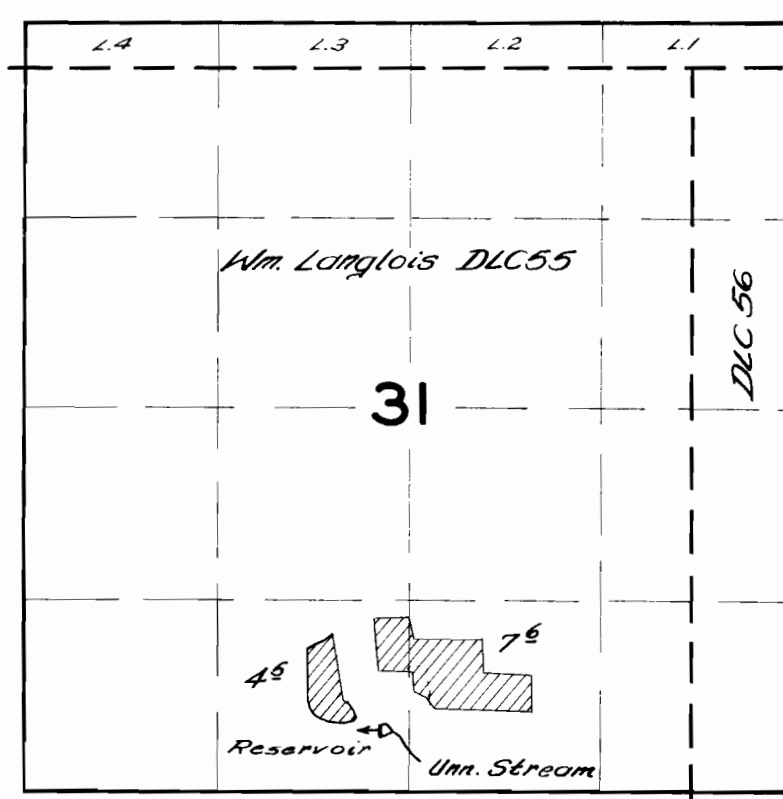

FINAL PROOF SURVEY UNDER

Application No. *R-26276* Permit No. *R-1237*
26277 *20624*
IN NAME OF

Ray Lowrey

Surveyed *July 20* *56* by *M. Bish*
May 24 *57* *C.O. Bartels*