


T.8S. R.4W. W.M.

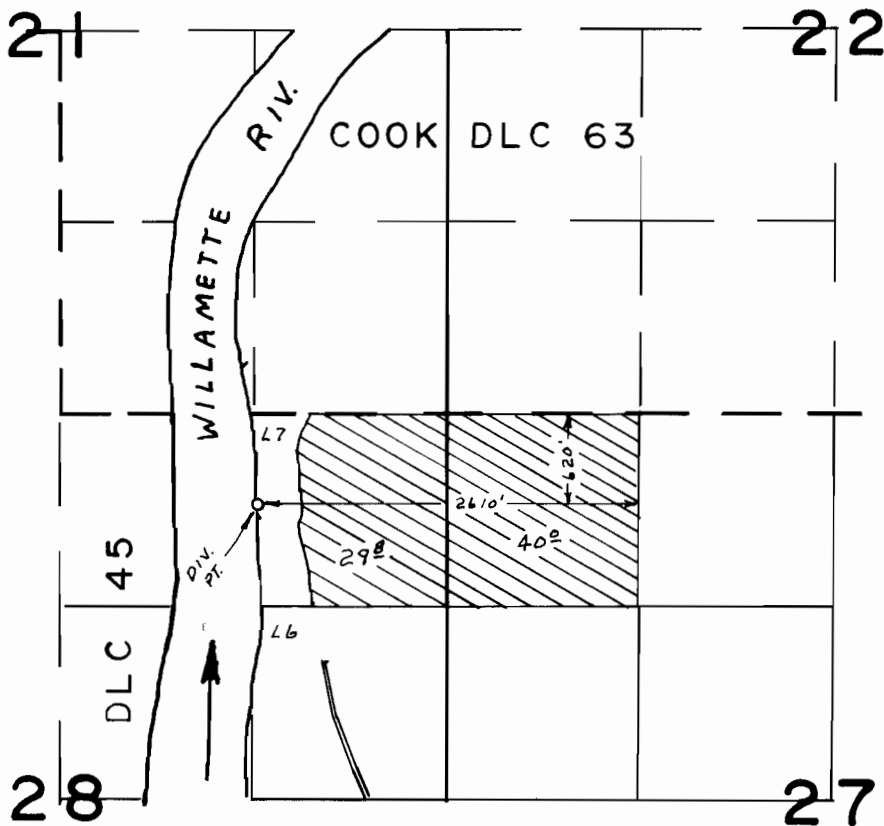

FINAL PROOF SURVEY
UNDER

Application No. 46553 Permit No. 34779
IN NAME OF
H.S.K., INC.

Surveyed SEP 5 1974, by LH NUNN