


T.3S. R.2W. W.M.

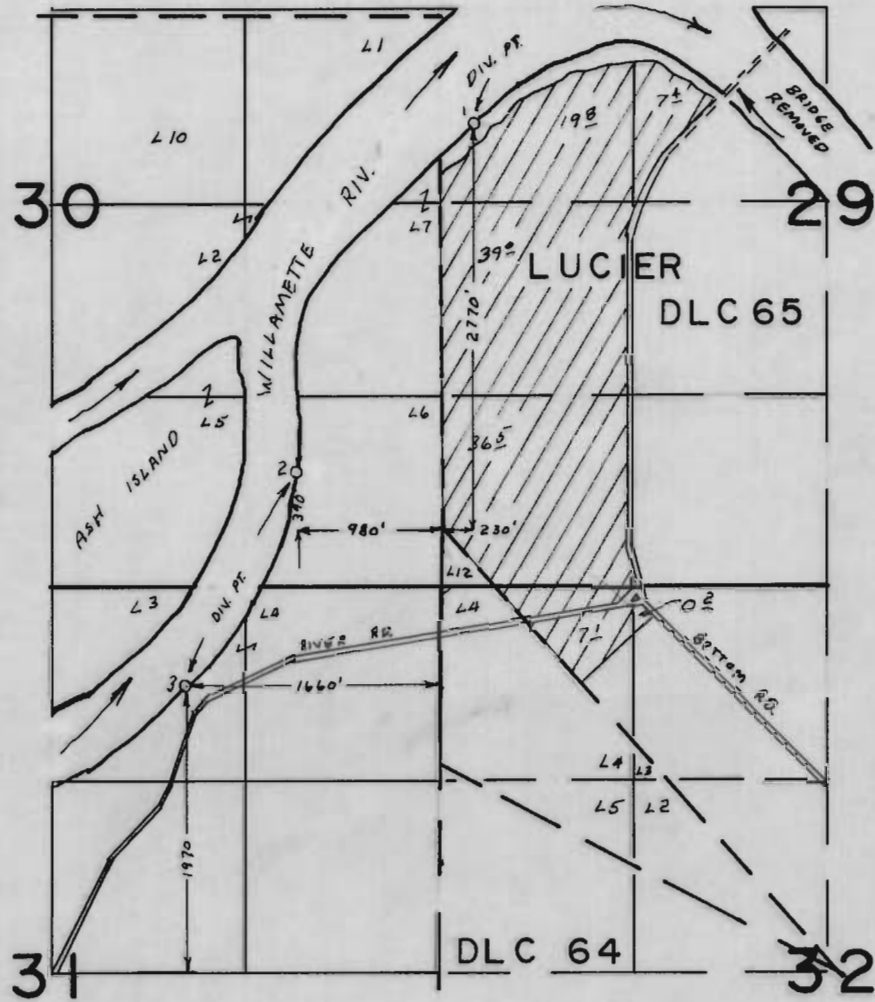

**FINAL PROOF SURVEY**  
UNDER

Application No. 48087 Permit No. 36113  
IN NAME OF

A. D. DORITY, JR.

Surveyed MAY 24 1974, by L. H. NUNN