


# T.4N., R.27E., W.M.

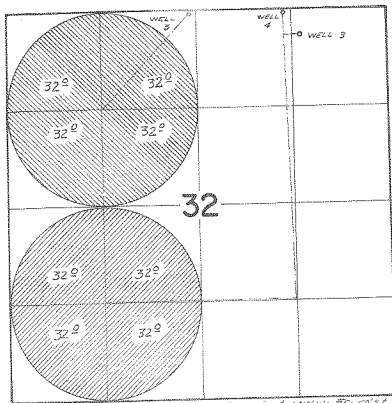

WELLS LOCATED: "1" - 340'S & 1180' W; "2" - 50'S & 190' W; "3" - 50'S & 270' W  
 ALL FROM NE COR 32.

## FINAL PROOF SURVEY UNDER

Application No. **G-3853**      **G-3629**  
**G-4140** Permit No. **G-3889**   
 IN NAME OF

**ESTATE OF ROY GAIL HOLZAPFEL**

Surveyed April 10 1974 by David L. Luby