
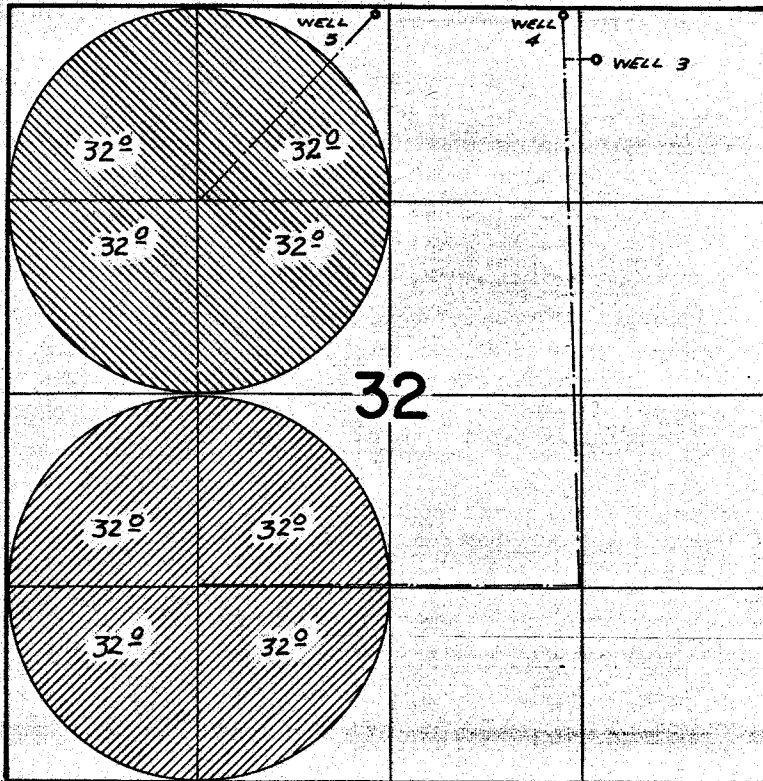


T.4N., R.27E., W.M.

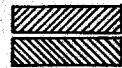

WELLS LOCATED: #3- 340'S & 1190' W; #4- 50'S & 1410' W; #5- 50'S & 2710' W
 ALL FROM NE COR 32.

FINAL PROOF SURVEY UNDER

Application No. **G-3853** Permit No. **G-3629**
G-4140 **G-3889** 

IN NAME OF

ESTATE OF ROY GAIL HOLZAPFEL

Surveyed April 10 1974, by David J. Torby