


T.6S.R.6W. WM

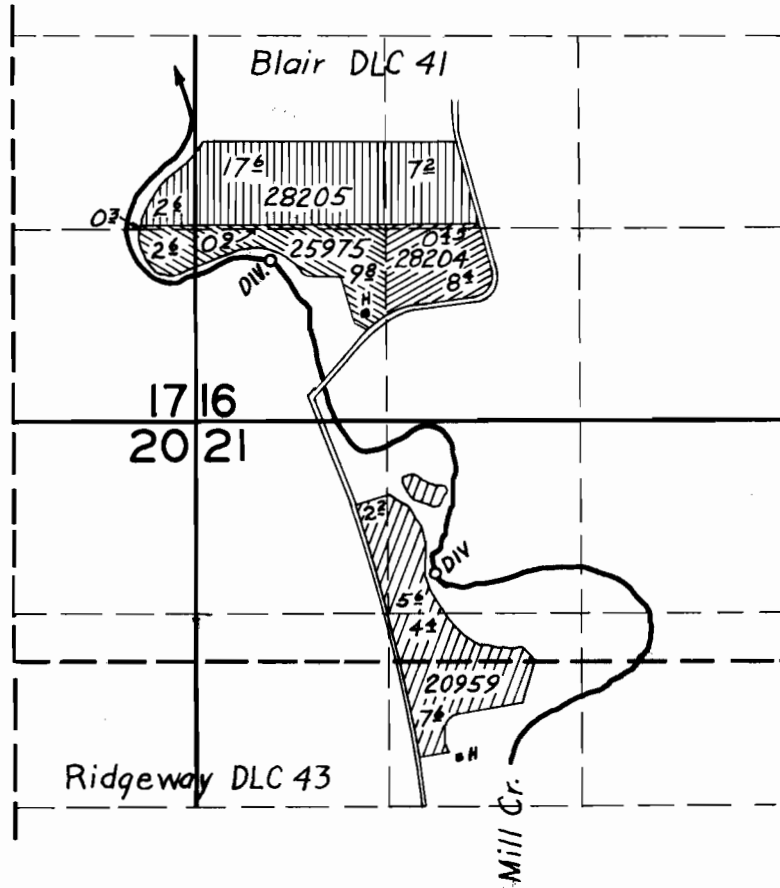

FINAL PROOF SURVEY

	20959	16406
	- 28205	22193
	28204	22192
Application No.	25975	Permit No. 20357
	Gerald R. Allen	
	Otto Debrick	
	Dan O. Blair	
 Dan O. Blair	

Surveyed July 12 19 54, by T. Jones.....