


T.1S.R.8W.W.M.

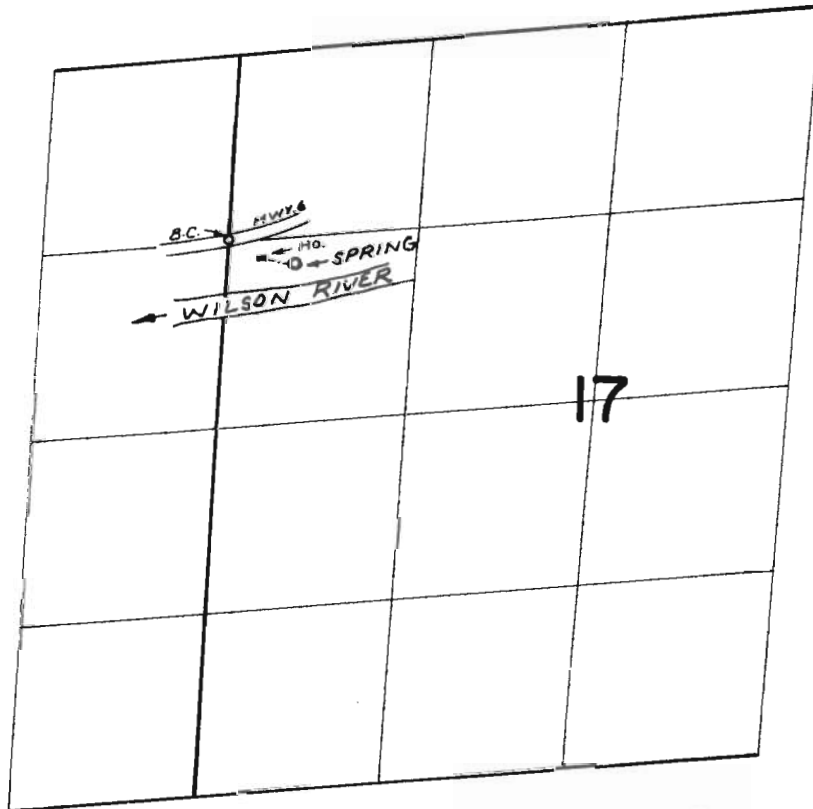

SPRING LOC: 180'S. & 440'E. FROM NW. COR. SW  $\frac{1}{4}$  NW  $\frac{1}{4}$  SEC. 17

**FINAL PROOF SURVEY**  
UNDER

**RECEIVED**

JAN 31 1977

Application No. 47847 Permit No. 35124 WATER RESOURCES DEPT  
IN NAME OF SALEM, OREGON

JACQUELINE H. WILKINSON

Surveyed SEPT. 12, 1974, by R. MUCKEN