


T.3N.,R.9W.,W.M.

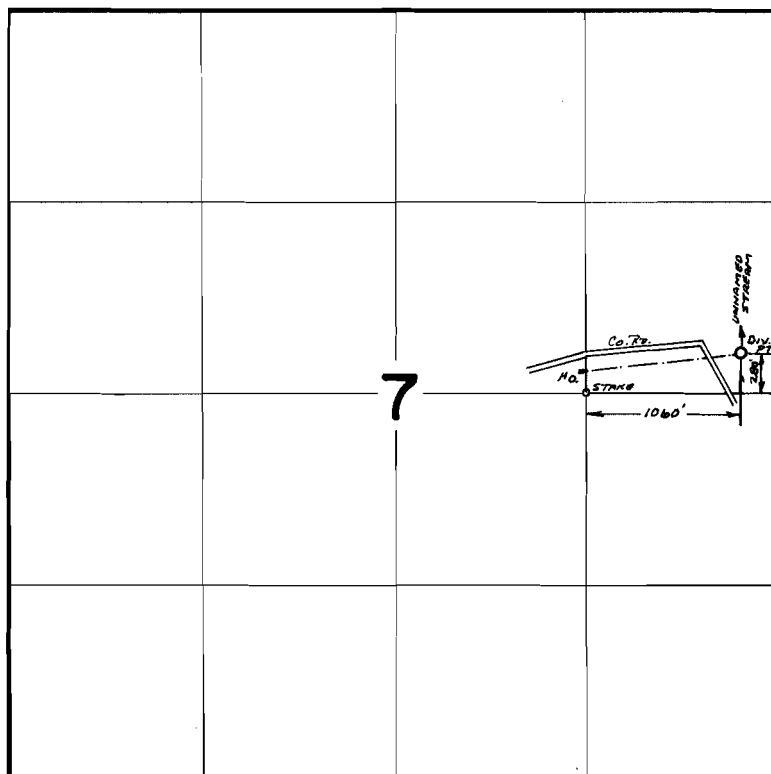

FINAL PROOF SURVEY
UNDER

Application No. **50460** Permit No. **37158**
IN NAME OF
ROBIN HOLM

Surveyed **JUNE 28** 1974, by **D. NORBY**