


# T. 1 N. R. 4 W. W. M.

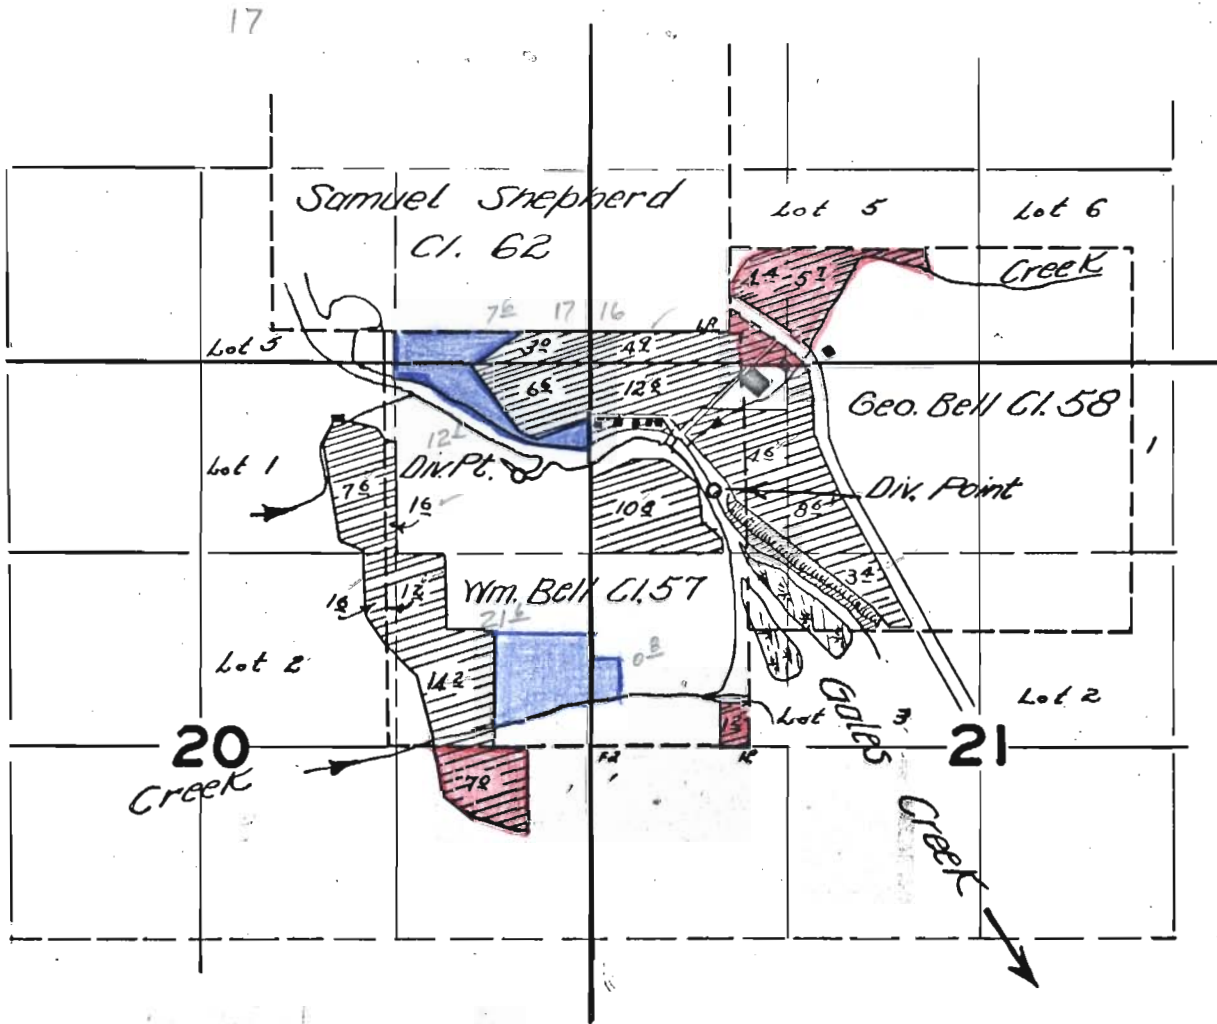

## FINAL PROOF SURVEY

UNDER

Application No. 15909... Permit No. J. 1746

IN NAME OF

JEAN K. & ROBERT H. WARRENS

Surveyed APRIL 2 1951., by H.L. COFFMAN