

WEST LINE DLC 57


MISLOCATED

GLD IN ERROR

TIN, RAW, WM.

SEE L-D IN

FILE 65575

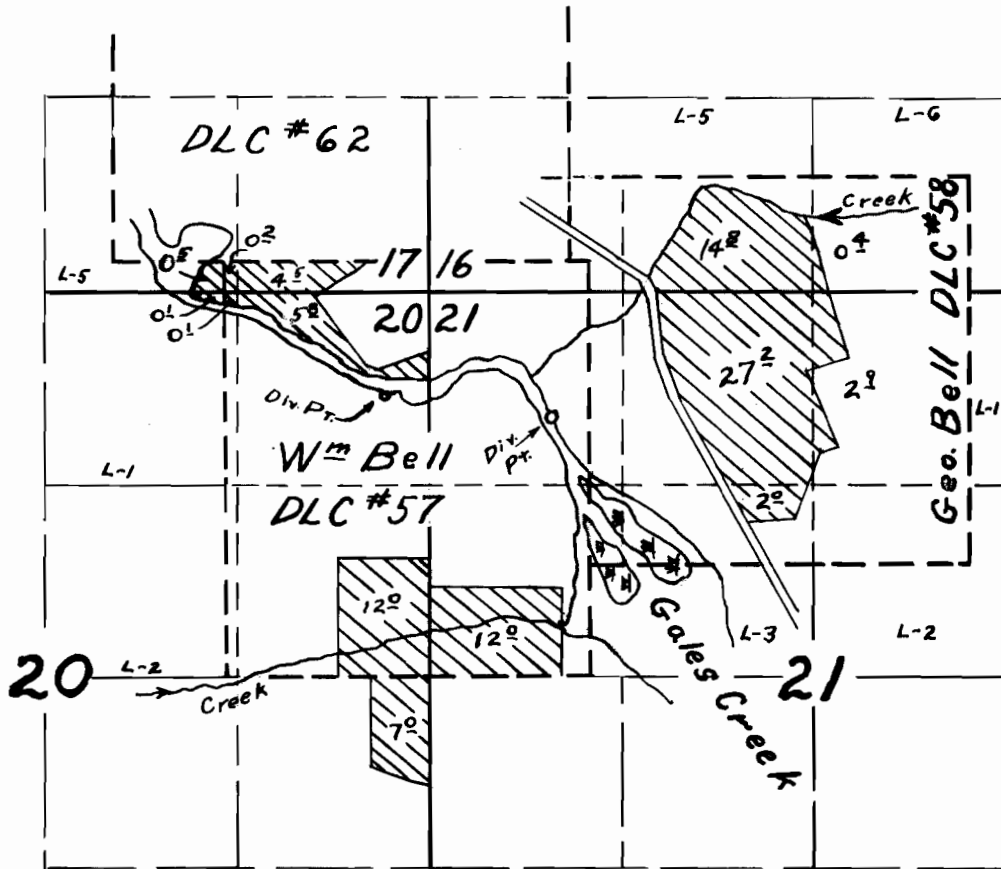

FINAL PROOF SURVEY

UNDER

Application No. 25716 Permit No. 20255

IN NAME OF

Jean K. & Robert H. Warrens

Surveyed 4-11 1956, by R.D. Best