


T. 1 S. R. 3 W. W. M.

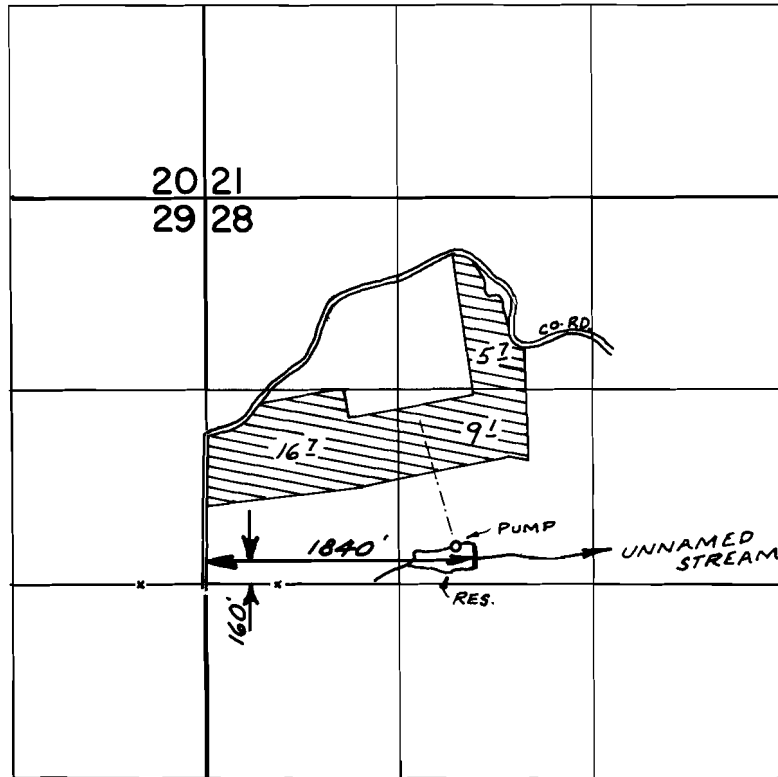

FINAL PROOF SURVEY UNDER

Application No. *R-48898* ~~48899~~ Permit No. *R-5756* ~~35724~~
IN NAME OF

ROY D. COOK

Surveyed *AUG. 6, 1975*, by *R. MUCKEN*
JUNE 15, 1972 *D. NORBY*