


# T. 1 S. R. 3 W. W. M.

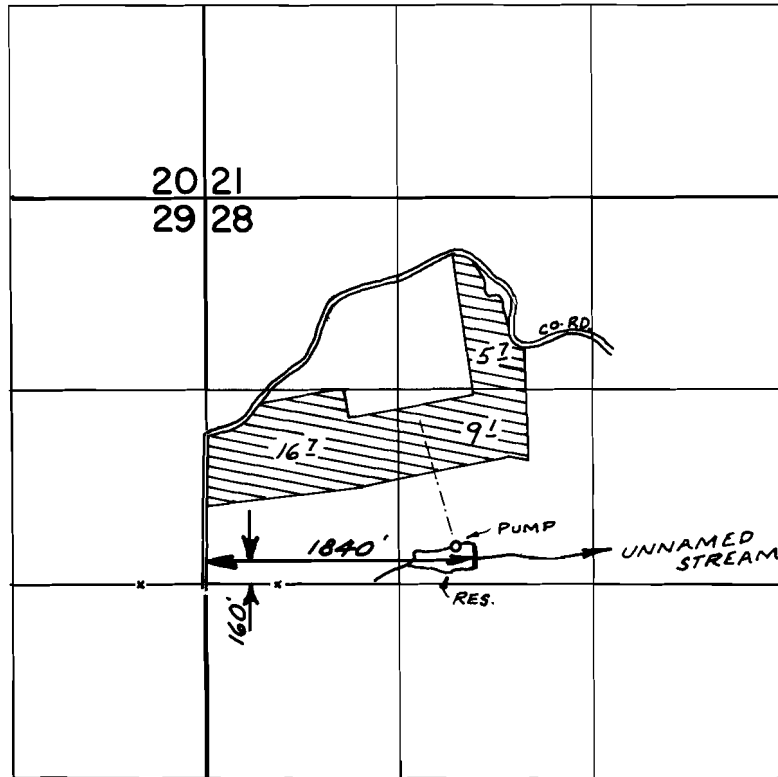

## FINAL PROOF SURVEY UNDER

Application No. *R-48898* ~~48899~~ Permit No. *R-5756* ~~35724~~  
IN NAME OF

*ROY D. COOK*

Surveyed *AUG. 6, 1975*, by *R. MUCKEN*  
*JUNE 15, 1972* *D. NORBY*