


T. 5 S. R. 6 W. W. M.

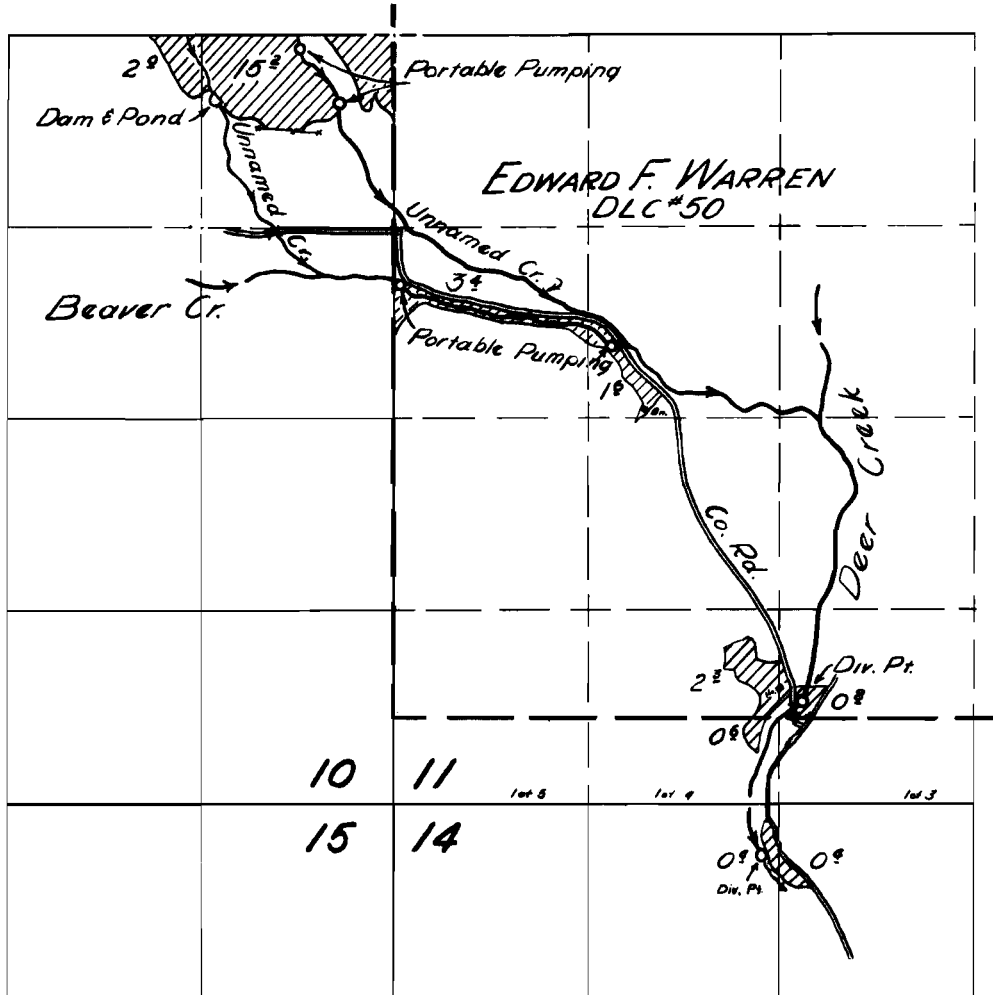

**FINAL PROOF SURVEY**  
UNDER

Application No. 27428 Permit No. 21596  
IN NAME OF

HAL E. WARNER

Surveyed 14 Mar 19 by [Signature]