


T.10S., R.7W., W.M.

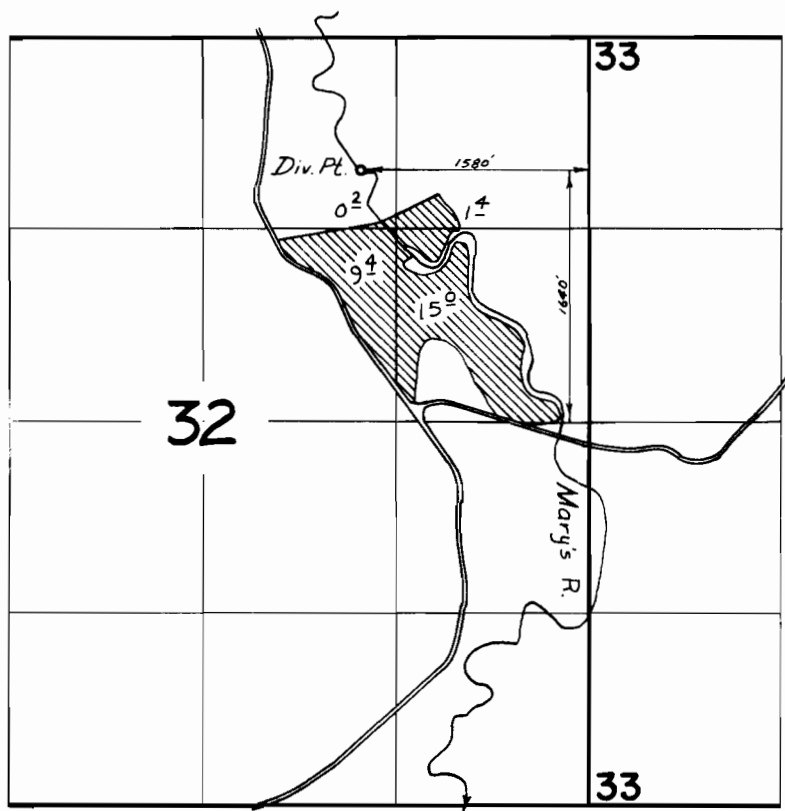

FINAL PROOF SURVEY
UNDER

Application No. 46719 Permit No. 34595
IN NAME OF

ARMAND T. & BEATRICE M. BEAUREGARD

Surveyed Aug. 8 1975, by D. Norby