


T.14S., R.5W., W.M.

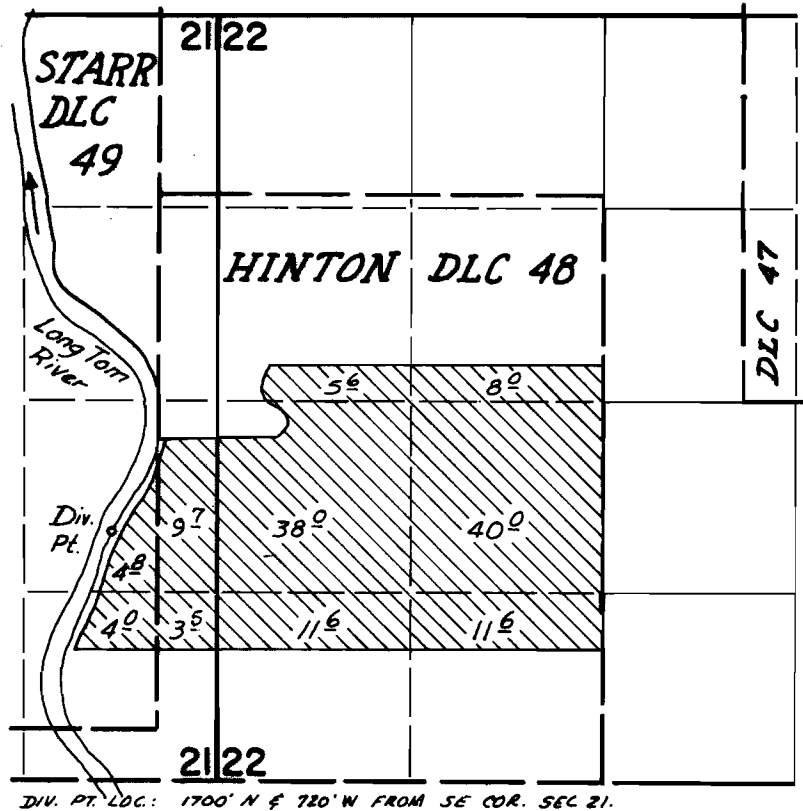

**FINAL PROOF SURVEY**  
UNDER

Application No. 47572 Permit No. 35618  
IN NAME OF

RAYMOND J. BECKER

Surveyed April 21 1975, by D. Norby