


T.11S., R.4&5W., W.M.

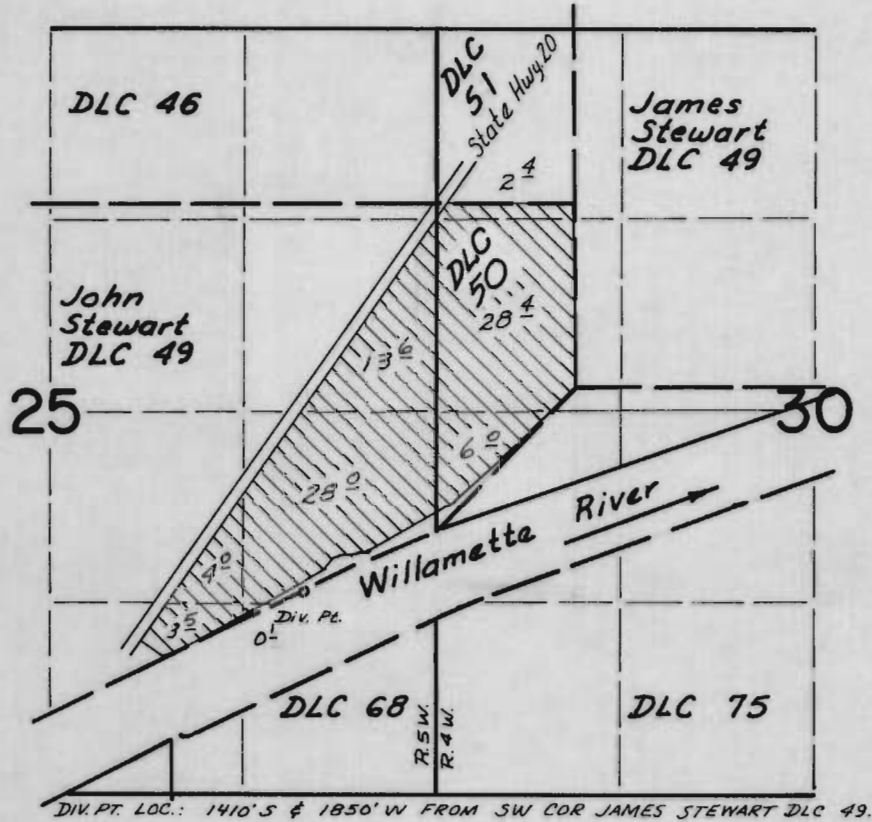

FINAL PROOF SURVEY
UNDER

Application No. 47619 Permit No. 35642
IN NAME OF

MARY M. GOLDBLATT AND ARTHUR L. McFADDEN

Surveyed Aug. 7 1975, by D. Norby