


T.12S., R.5W., W.M.

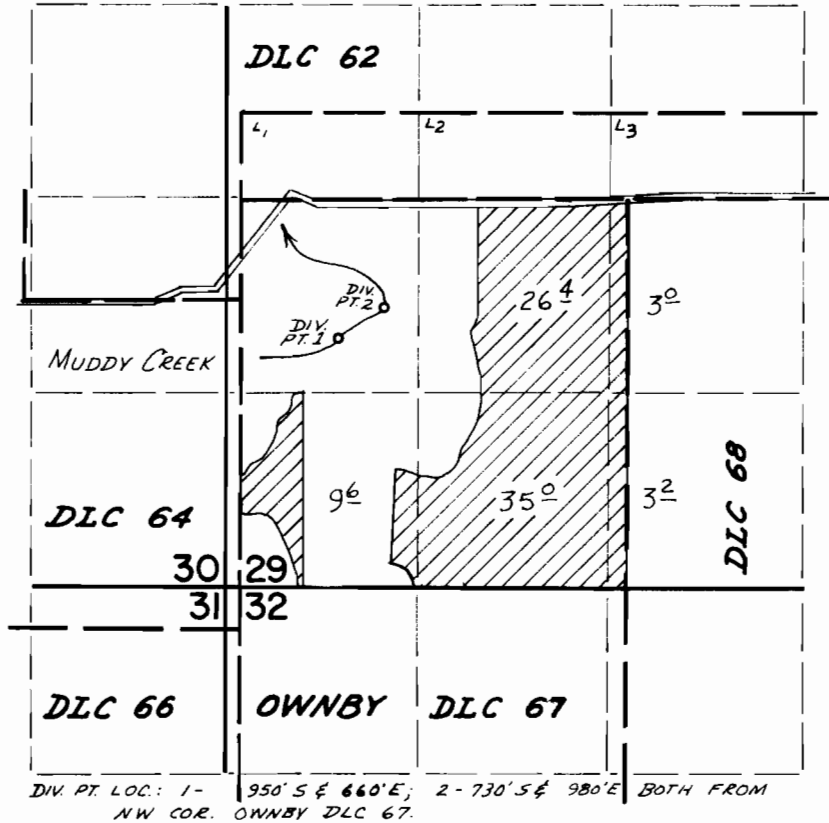

**FINAL PROOF SURVEY**  
UNDER

Application No. 52408 Permit No. 37656  
IN NAME OF

STANLEY L. STARR

Surveyed Aug 14 1975, by D. Norby