


T.14S., R.8W., W.M.

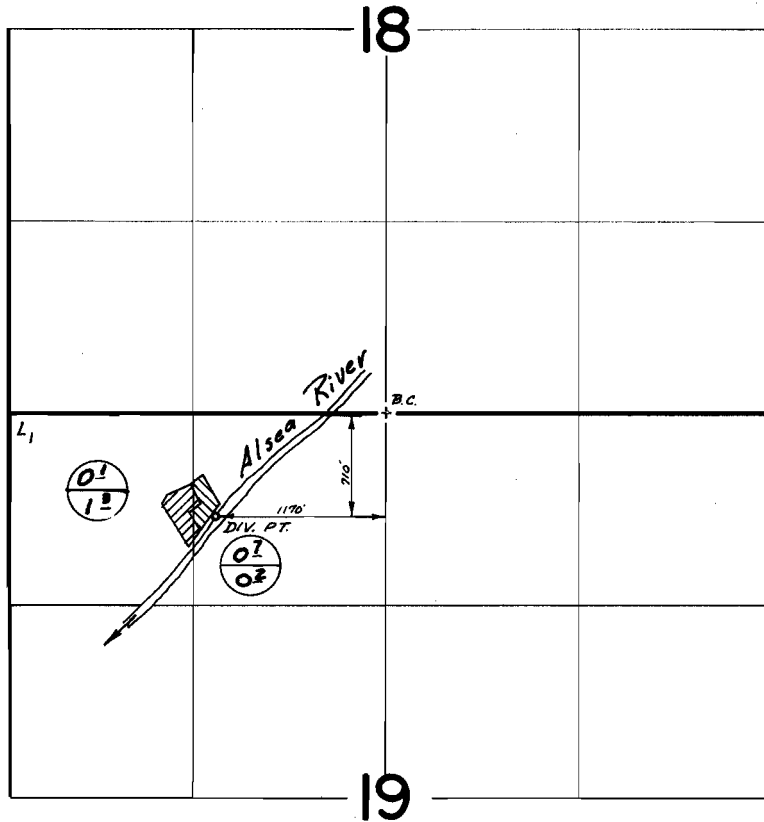

FINAL PROOF SURVEY
UNDER

Application No. 47715 50436 Permit No. 35744 37109
IN NAME OF

GEORGE W. MITCHELL

Surveyed July 2 1975, by D. Norby

