


T. 2 S. R. 4 E. W. M.

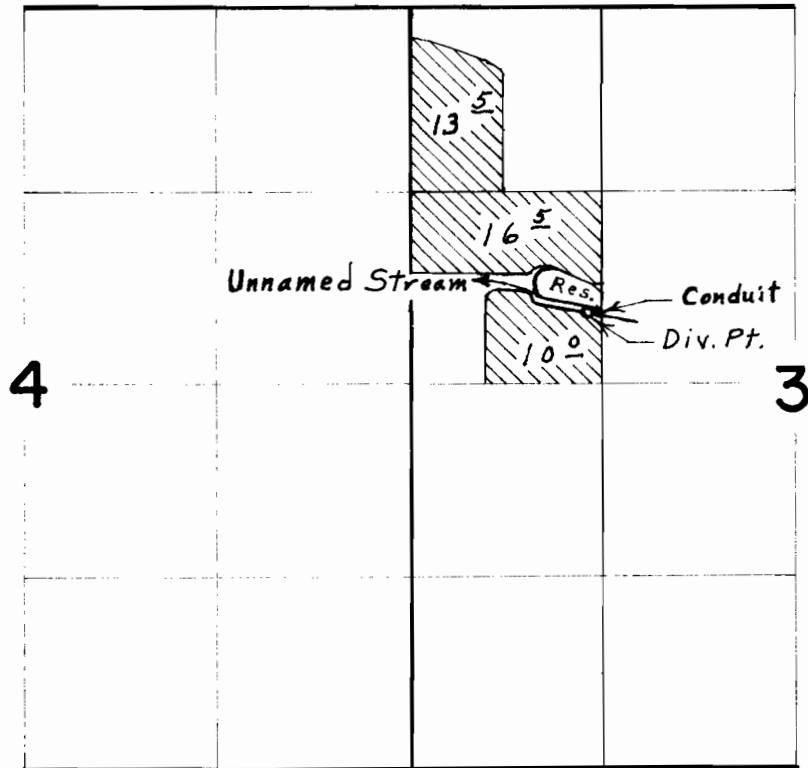

Div. Pt. located 2100' S. & 1220' E. from N.W. Cor. Sec. 3

FINAL PROOF SURVEY




EDWARD M. NELSON

Surveyed Aug. 28, 1975, by L. E. Gould