


T.4S., R.4E., W.M.

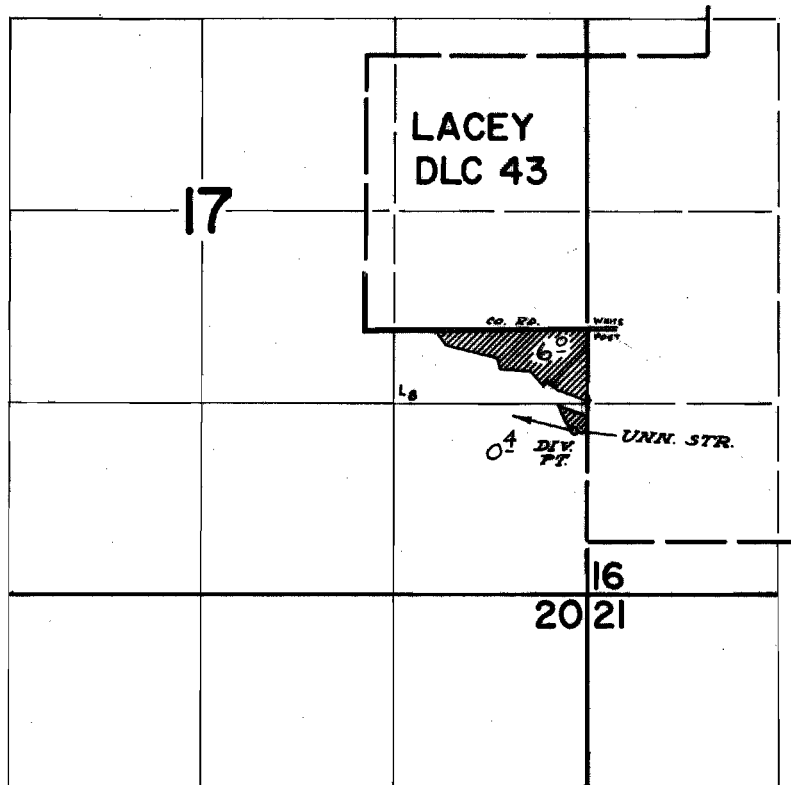

DIV. PT. LOCATED: 700'S & 90' W FROM NE COR. LOT 8, SEC 17.

FINAL PROOF SURVEY
UNDER

Application No. 47073 Permit No. 35345
IN NAME OF

DENNIS B. O'HALLORAN

Surveyed Sept. 18 1974, by D. G. Goby