T. 3N. R.1&2 W. W.M.

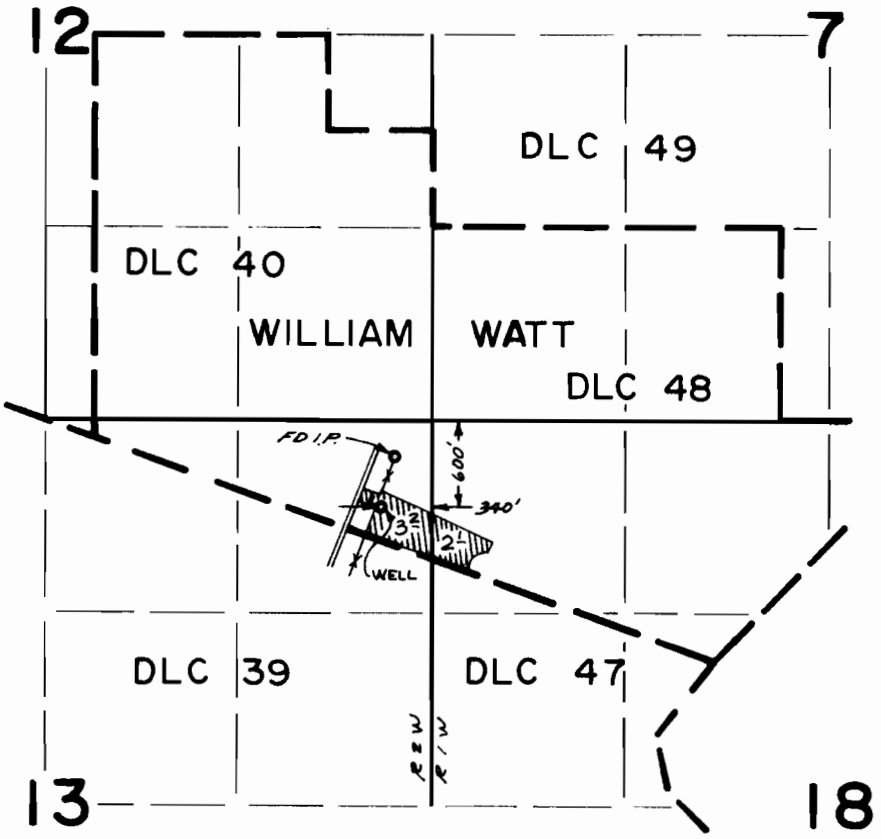

FINAL PROOF SURVEY
UNDER

Application No. G3930 Permit No. G3688
IN NAME OF

LOUIS SENNER

Surveyed JUNE 9 19 75, by R.G. MUCKEN

1975 G CRK