


T.7N. R.2W. W.M.

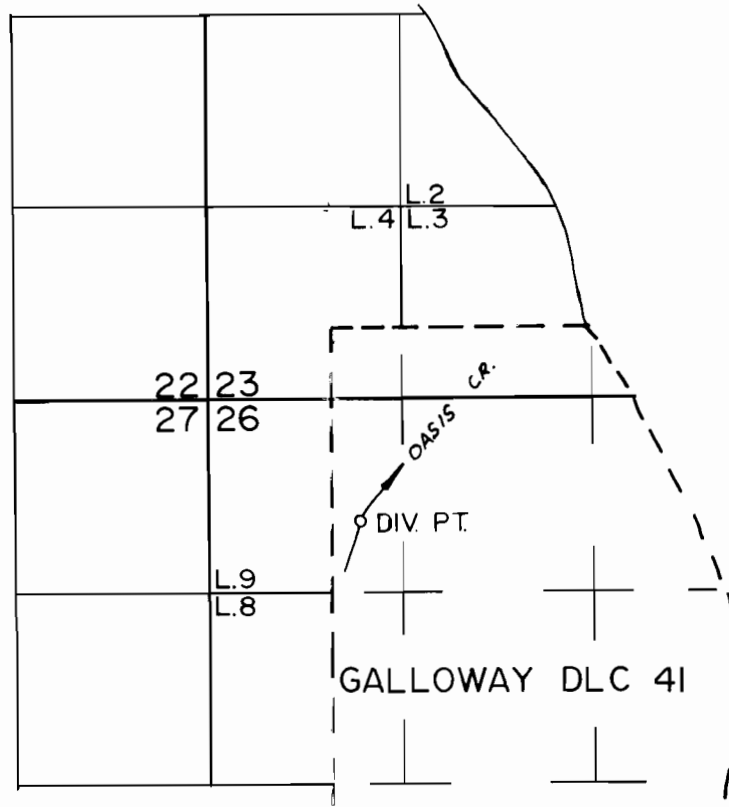

DIV. PT. LOC. 1320'S & 180'E FROM NW COR. GALLOWAY DLC 41

FINAL PROOF SURVEY
UNDER

Application No. 42332..... Permit No. 31647.....
IN NAME OF

..... C. M. KELLEY

Surveyed JUNE 30 1976., by L.H. NUNN.....