


T.7N. R.3W. W.M.

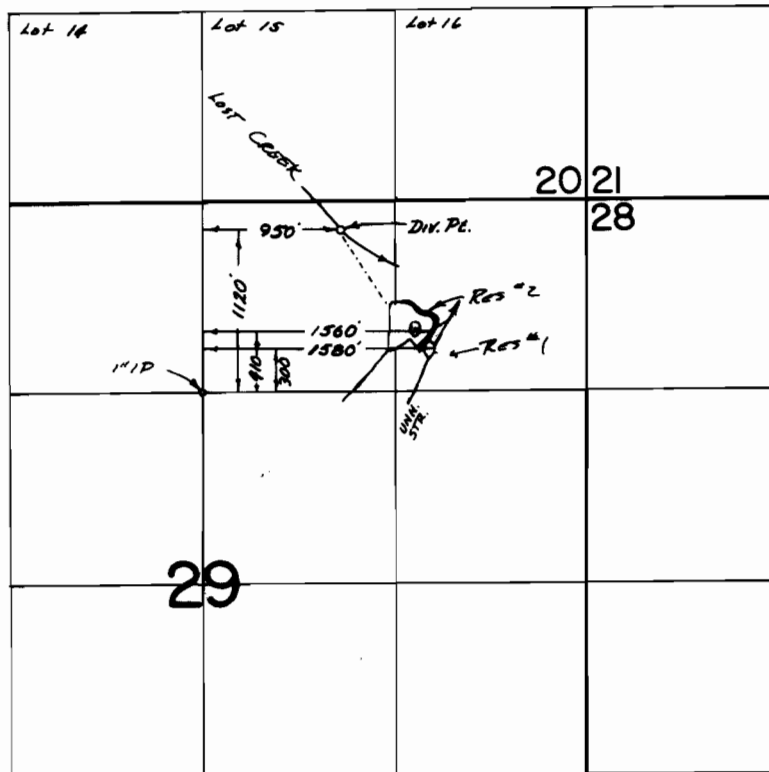

FINAL PROOF SURVEY
UNDER

R-46716 R-5588
Application No. 46717 Permit No. 34910
IN NAME OF

THEODORE W. & PHILLIS L. BINNS

Surveyed Oct. 2, 1974, by L. H. NUNN..
Oct. 1, 1975, D. Norby