


T.8N. R.3 & 4W. W.M.

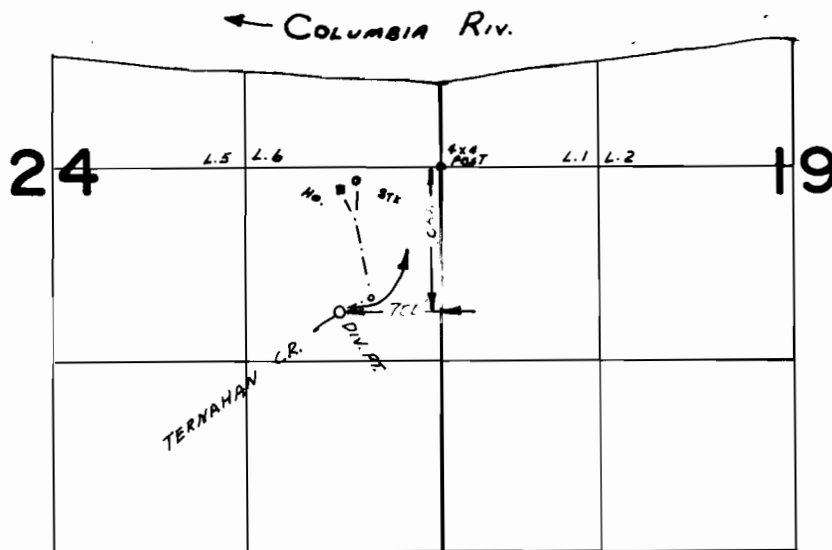

FINAL PROOF SURVEY UNDER

Application No. 51020..... Permit No. 38508.....
IN NAME OF

E. HENRY & JUNE H. GAPSCH.....

Surveyed JUNE 8... 1976., by L.H. NUNN.....