


T.28S. R.14W. W.M.

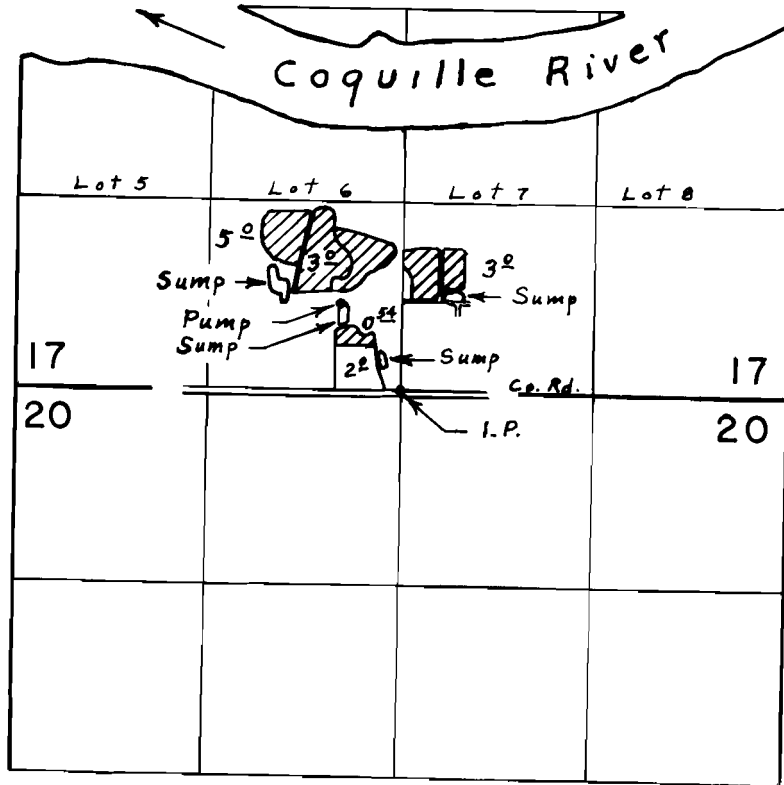

Sump Well located 520' N. & 400' W. from S. $\frac{1}{4}$ Cor. Sec. 17.

FINAL PROOF SURVEY UNDER

Application No. G-5697 Permit No. G-5506
IN NAME OF

LOUIS PALLIN

Surveyed July 15, 1976, by L. E. Gould