T.28S. R.12&13W. W.M.

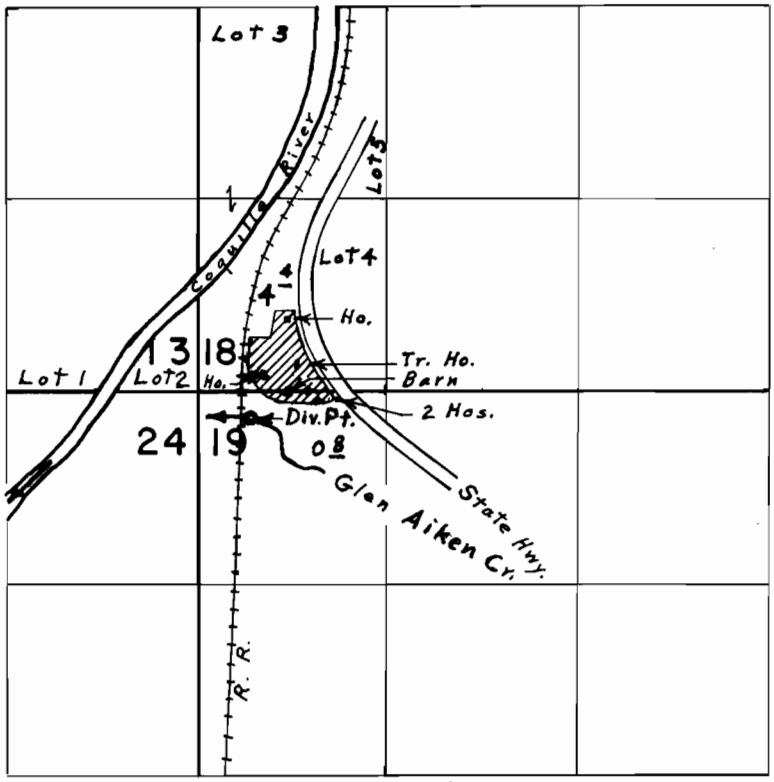

Div. Pt. located 180' S. & 370' E. from N.W. Cor. Sec. 19

FINAL PROOF SURVEY
UNDER

Application No. 39002 Permit No. 29209
IN NAME OF

DONALD H. FARR

Surveyed Oct. 27, 1975, by L. E. Gould

COB-3HH-79