


T.28S. R.10W. W.M.

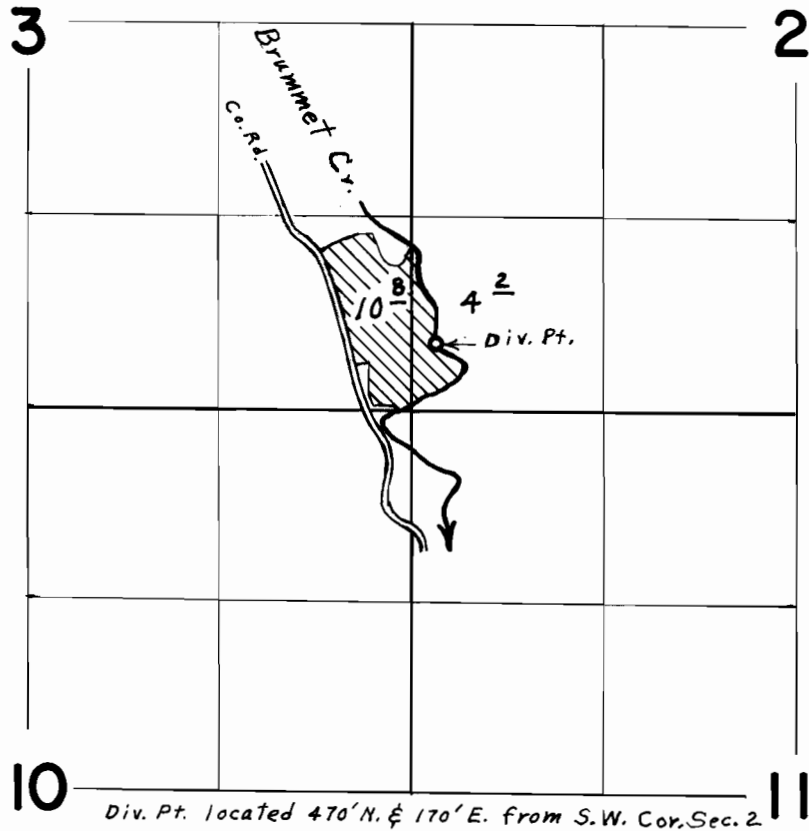

**FINAL PROOF SURVEY**  
UNDER

Application No. 39464 Permit No. 29301  
IN NAME OF

ESTATE OF JOHN E. KIRK

Surveyed Oct. 29, 1975, by L. E. Gould