


T.28 S. R.11 W. W.M.

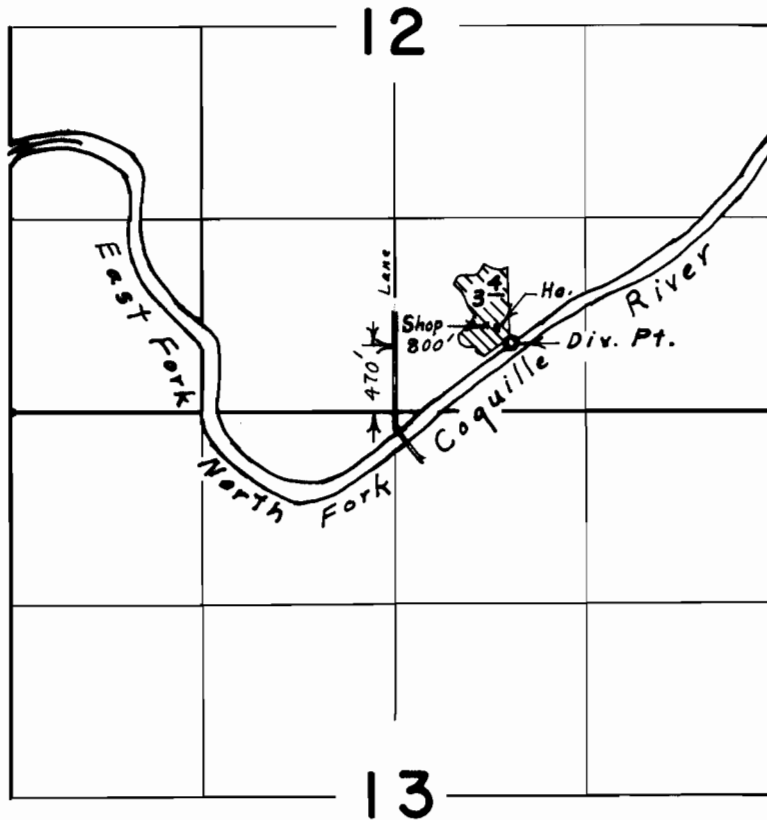

FINAL PROOF SURVEY
UNDER

Application No. 39758 Permit No. 29569
IN NAME OF

J. LEONARD & MILDRED N. JOHNSON

Surveyed Oct. 24, 1975, by L. E. Gould