


T.28S. R.10W. W.M.

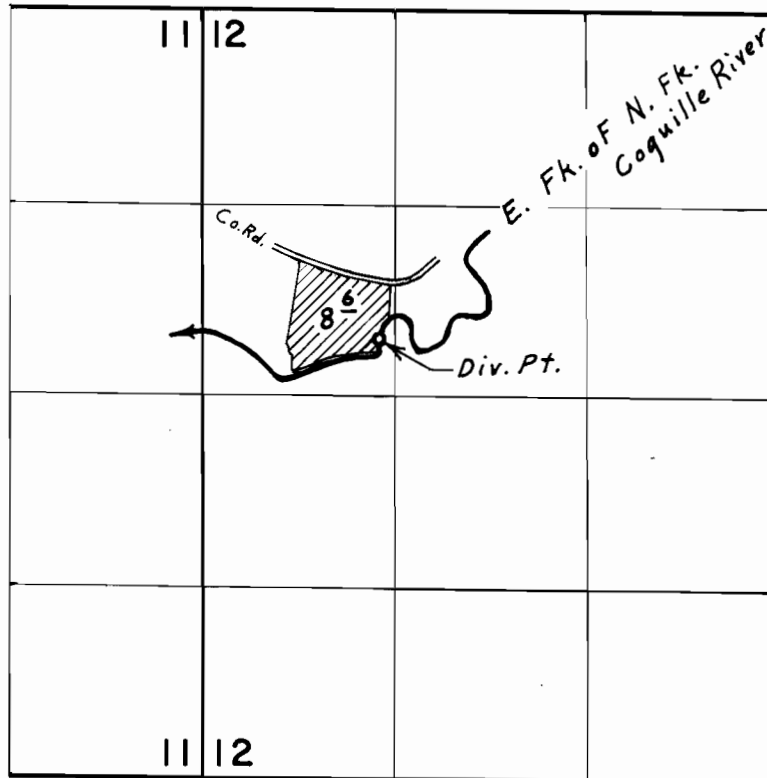

Div. Pt. located 2260' S. & 1220' E. from N.W. Cor. Sec. 12

FINAL PROOF SURVEY
UNDER

Application No. 39844 Permit No. 29661
IN NAME OF

GEORGE M. & CHRISTINE SEELY

Surveyed Oct. 28, 1975, by L. E. Gould