


T.28 S. R.10 W. W.M.

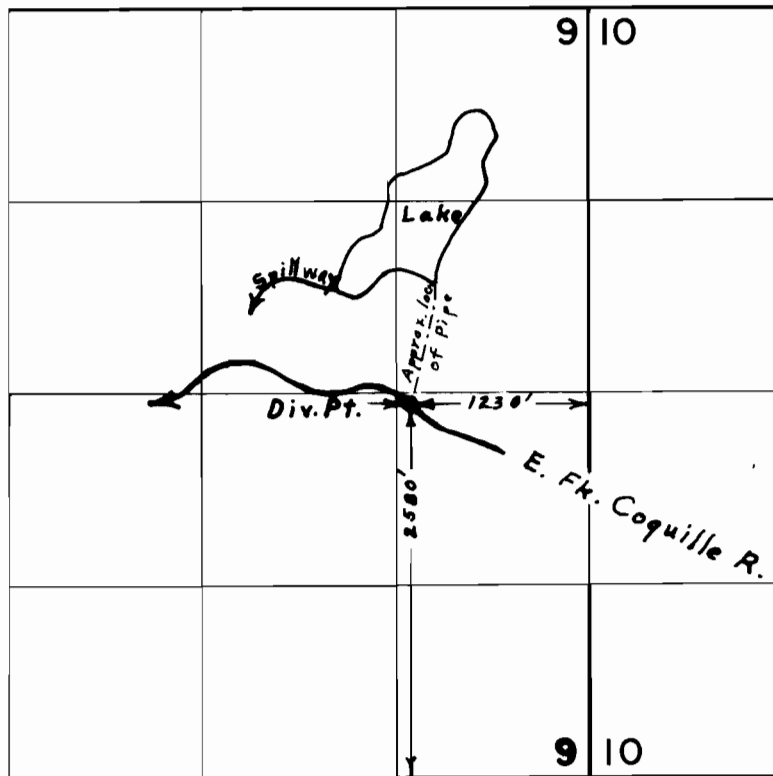

FINAL PROOF SURVEY
UNDER

Application No. 42639 Permit No. 31848
IN NAME OF

K. C. CHAN & J. L. BOGNAR

Surveyed Oct. 25, 1975, by L. E. Gould