


# T. 28 S. R. 14 W. W. M.

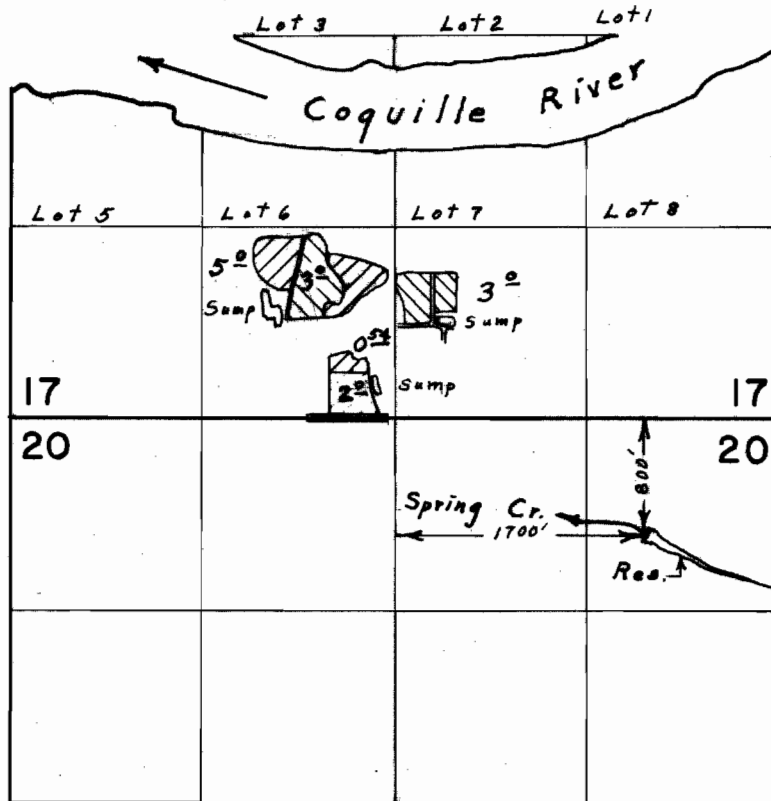

Primary   
Supplemental 

## FINAL PROOF SURVEY UNDER

Application No. 45004 Permit No. 33632  
IN NAME OF

LOUIS PALLIN

Surveyed April 11, 1972, by L. E. Gould