


T.41S.,R.13W.,W.M.

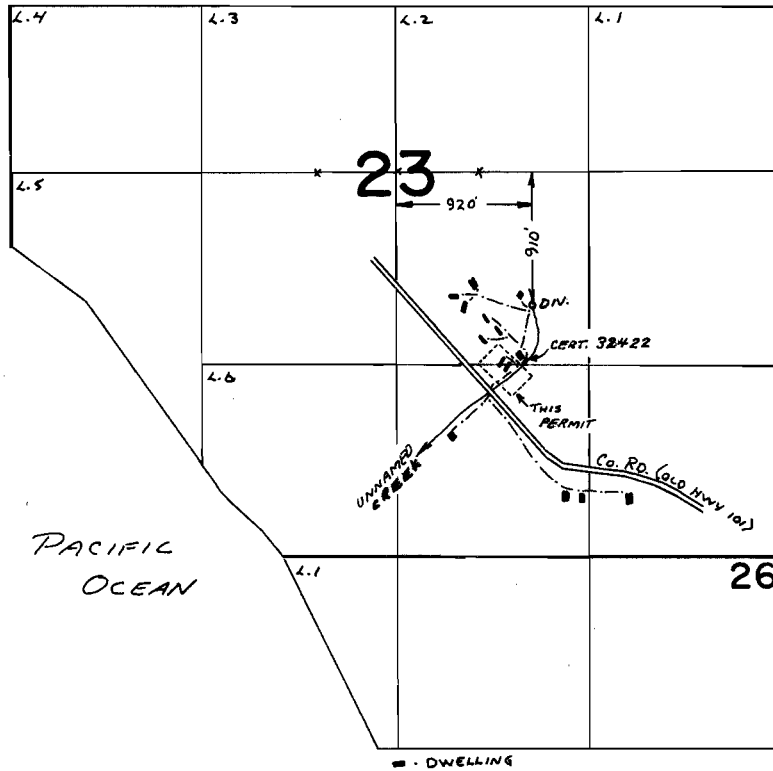

FINAL PROOF SURVEY UNDER

Application No. 48228 Permit No. 36220
IN NAME OF

DONALD J. FARMER

Surveyed July 18 1975 by L. Toll