


T.40S. R.13W. W.M.

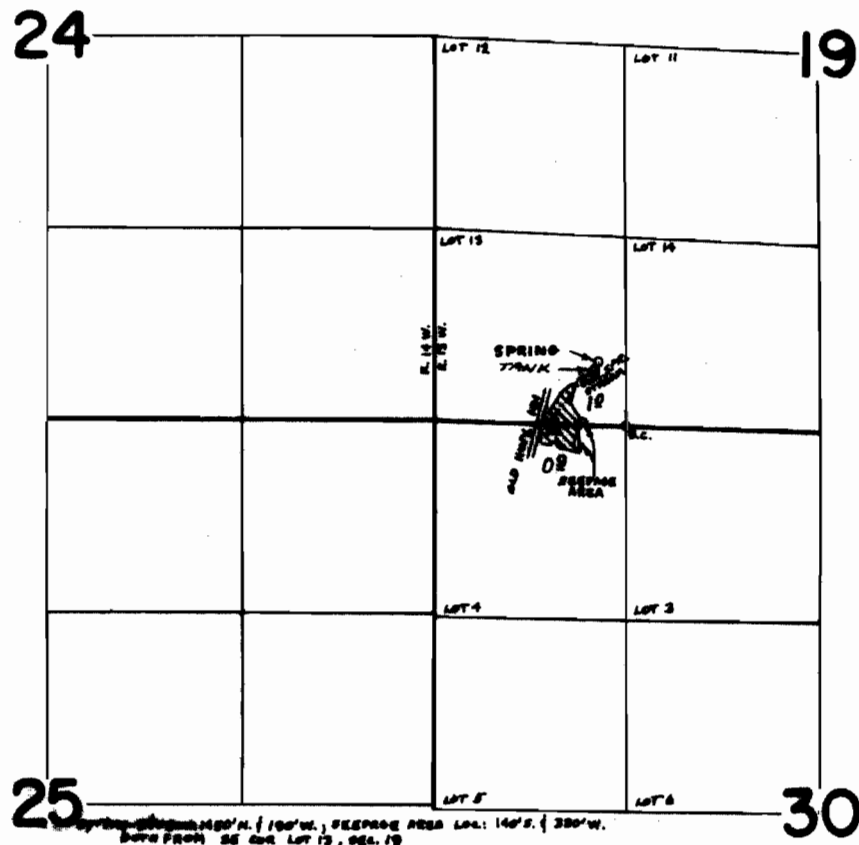

FINAL PROOF SURVEY

UNDER

Application No. 48684 Permit No. 36502
IN NAME OF

BENJAMIN D. ANDREASON

Surveyed JULY 23 1975, by L. TOLL.....