


T.28S. R.7W. W.M.

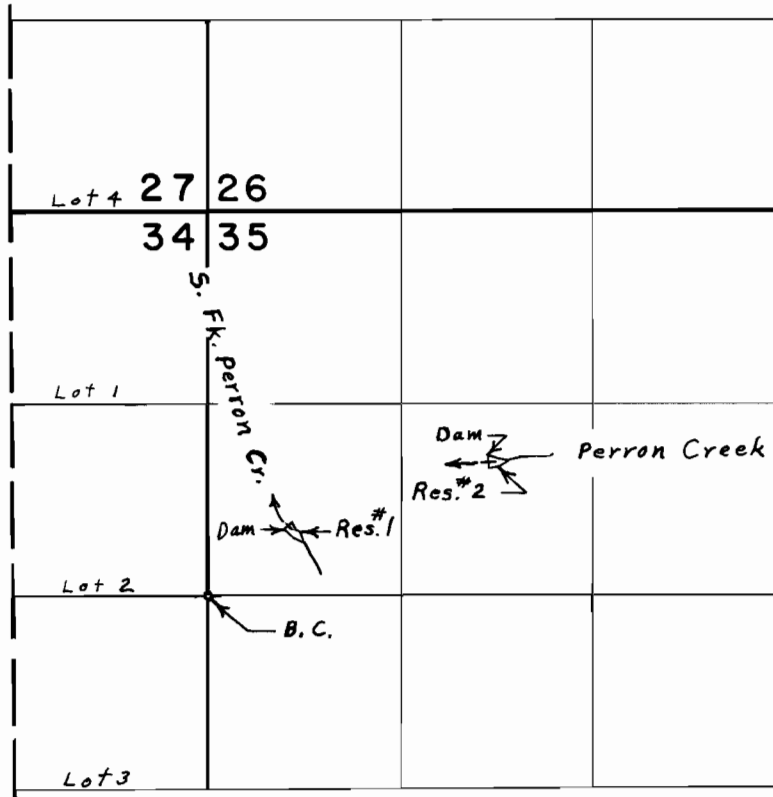

FINAL PROOF SURVEY
UNDER

Application No. R-50967 Permit No. R-6198..
IN NAME OF

DAVID GEORGE PERRON, SR.

Surveyed July 29, 1976, by L. E. Gould