


T.13S., R.28E., W.M.

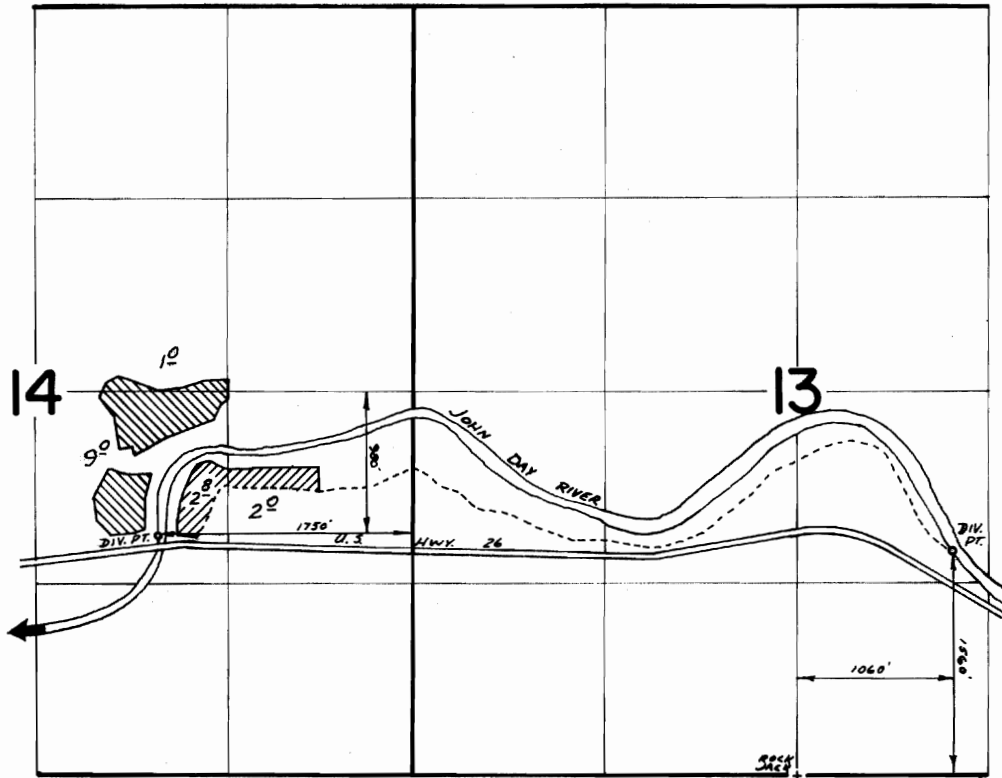

**FINAL PROOF SURVEY**  
UNDER

Application No. 42491 Permit No. 31774  
47039 35184   
IN NAME OF

HANS C. & MARY B. ESKILDSON

Surveyed June 21 1975, by D. Norby