


T.23 S. R.32 E. W.M.

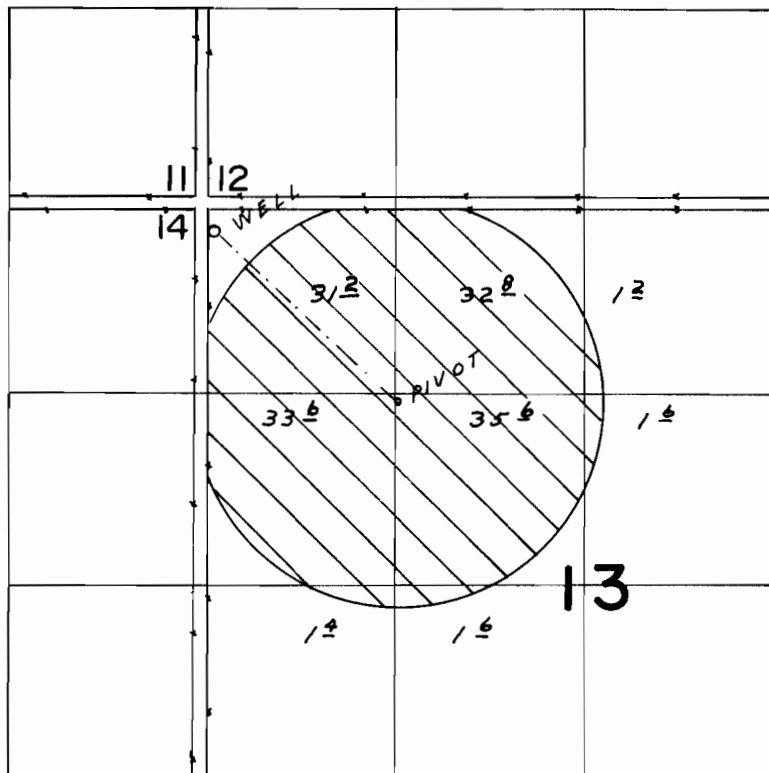

WELL LOC. 190'S. & 90'E FROM NW COR. SEC. 13

FINAL PROOF SURVEY
UNDER

Application G-5439 Permit No. G-4923
IN NAME OF _____

PATRICIA HAYES

Surveyed JUL. 23 1975, by LH NUNN