


T. 38 S. R. 1 W. W.M.

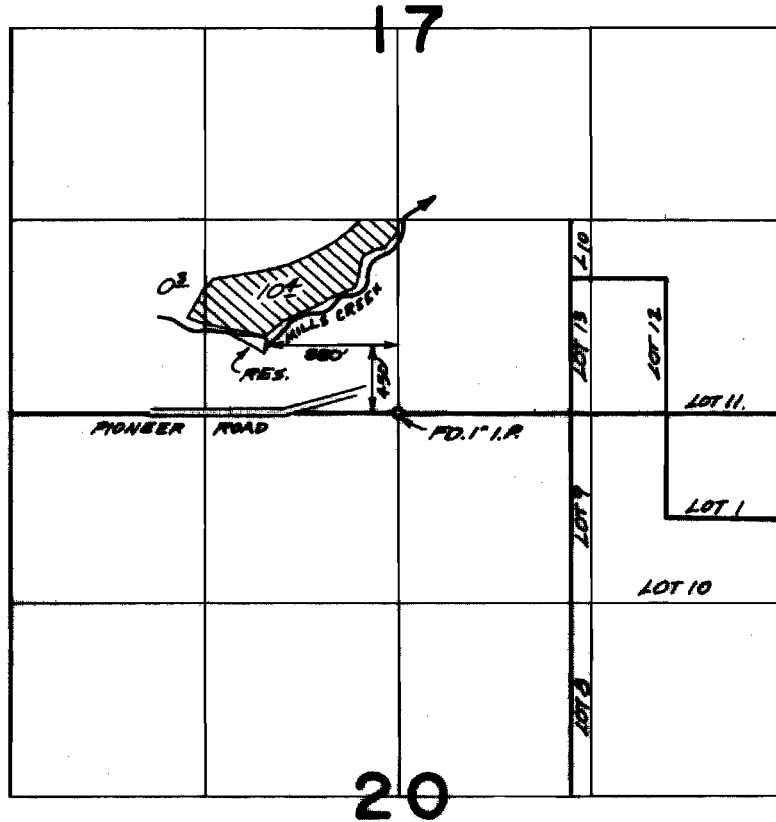

FINAL PROOF SURVEY UNDER

R 45782 R 5355
Application No. ~~45783~~ Permit No. ~~33846~~
IN NAME OF

.....BERTHA W. GAMMILL.....

Surveyed JULY 15 1974, by L.M. TOLL.....