


T.36S.,R.3W.,W.M.

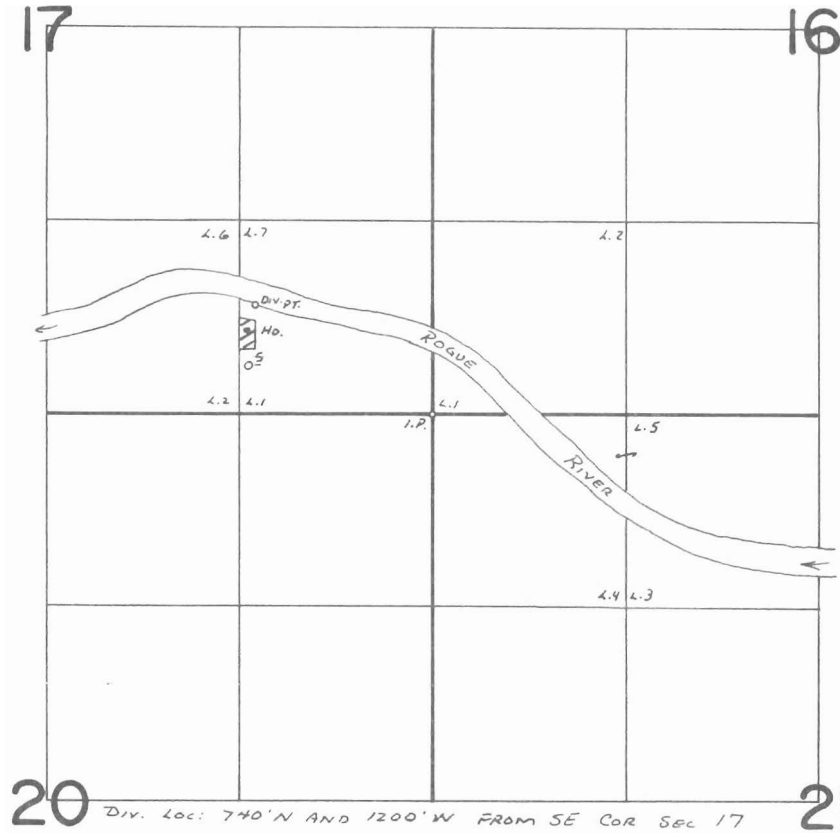

FINAL PROOF SURVEY
UNDER

Application No. **46419** Permit No. **34684**
IN NAME OF

RECEIVED

NOV 19 1976

Surveyed Aug. 14, 1975, by **L. E. GOULD**

WATER RESOURCES DEPT
SALEM, OREGON