


T.34S. R.1W. W.M.

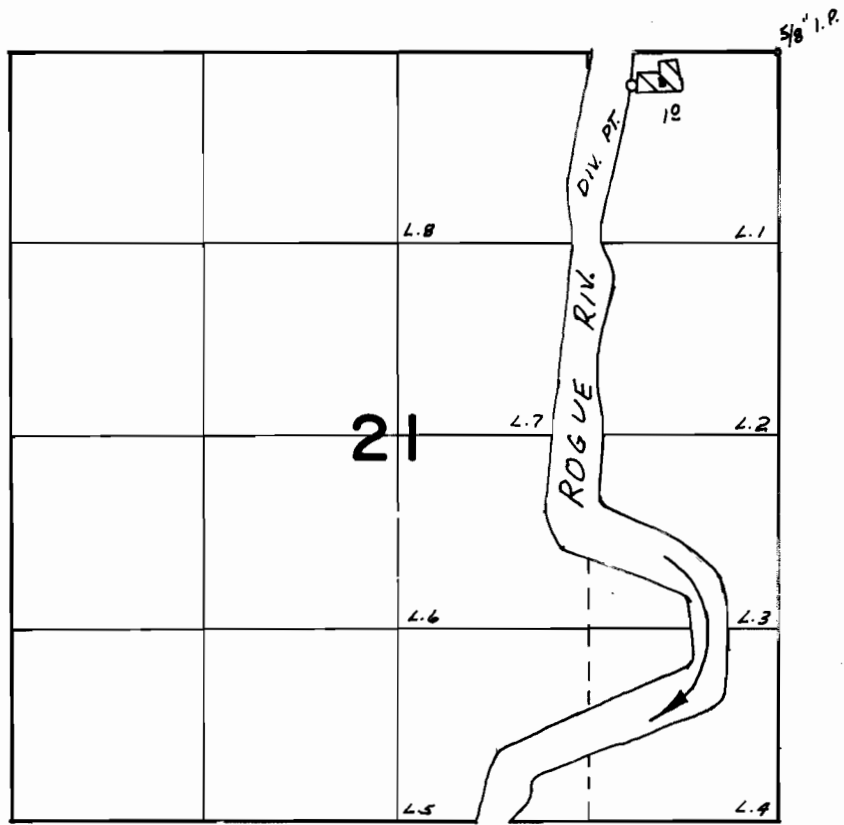

DIV. PT. LOC. 230'S. & 1000' W FROM NE COR. SEC. 21

FINAL PROOF SURVEY UNDER

Application No. 48471..... Permit No. 36379.....
IN NAME OF

C. MARION & JULIA SMITH.....

Surveyed APR. 28. 1975., by L.H. NUNN.....