


T.13S.,R.11E.,W.M.

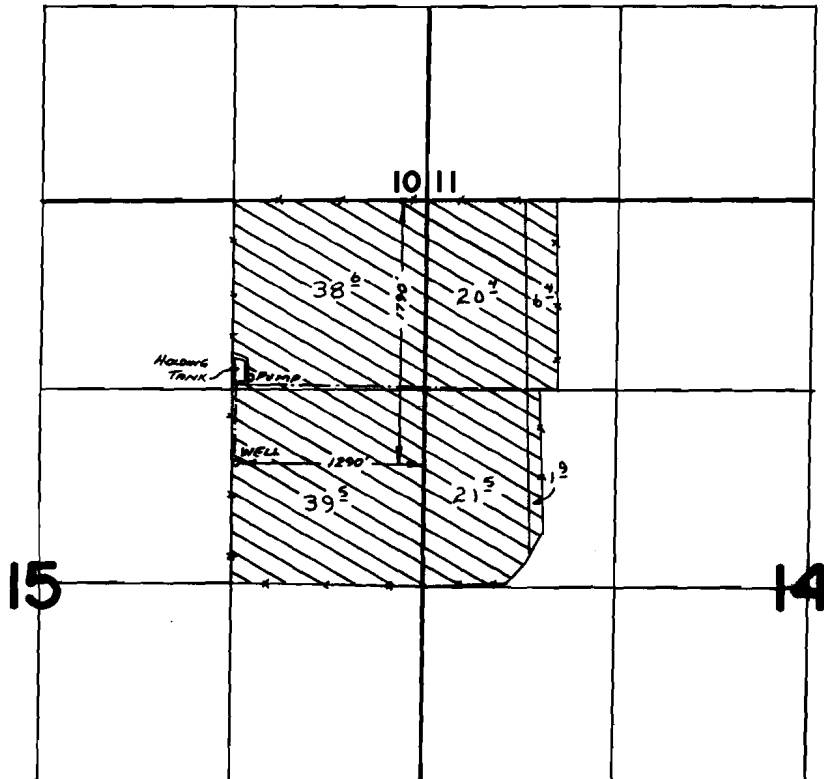

FINAL PROOF SURVEY UNDER

Application No. G-2363 Permit No. G-2179
IN NAME OF

WILLIAM PAUL & RUTH ALLEY

Surveyed JUNE 18 1975, by L. E. GARD

g-2179
PTS 1975-4 407