


T.31S., R.41E., W.M.

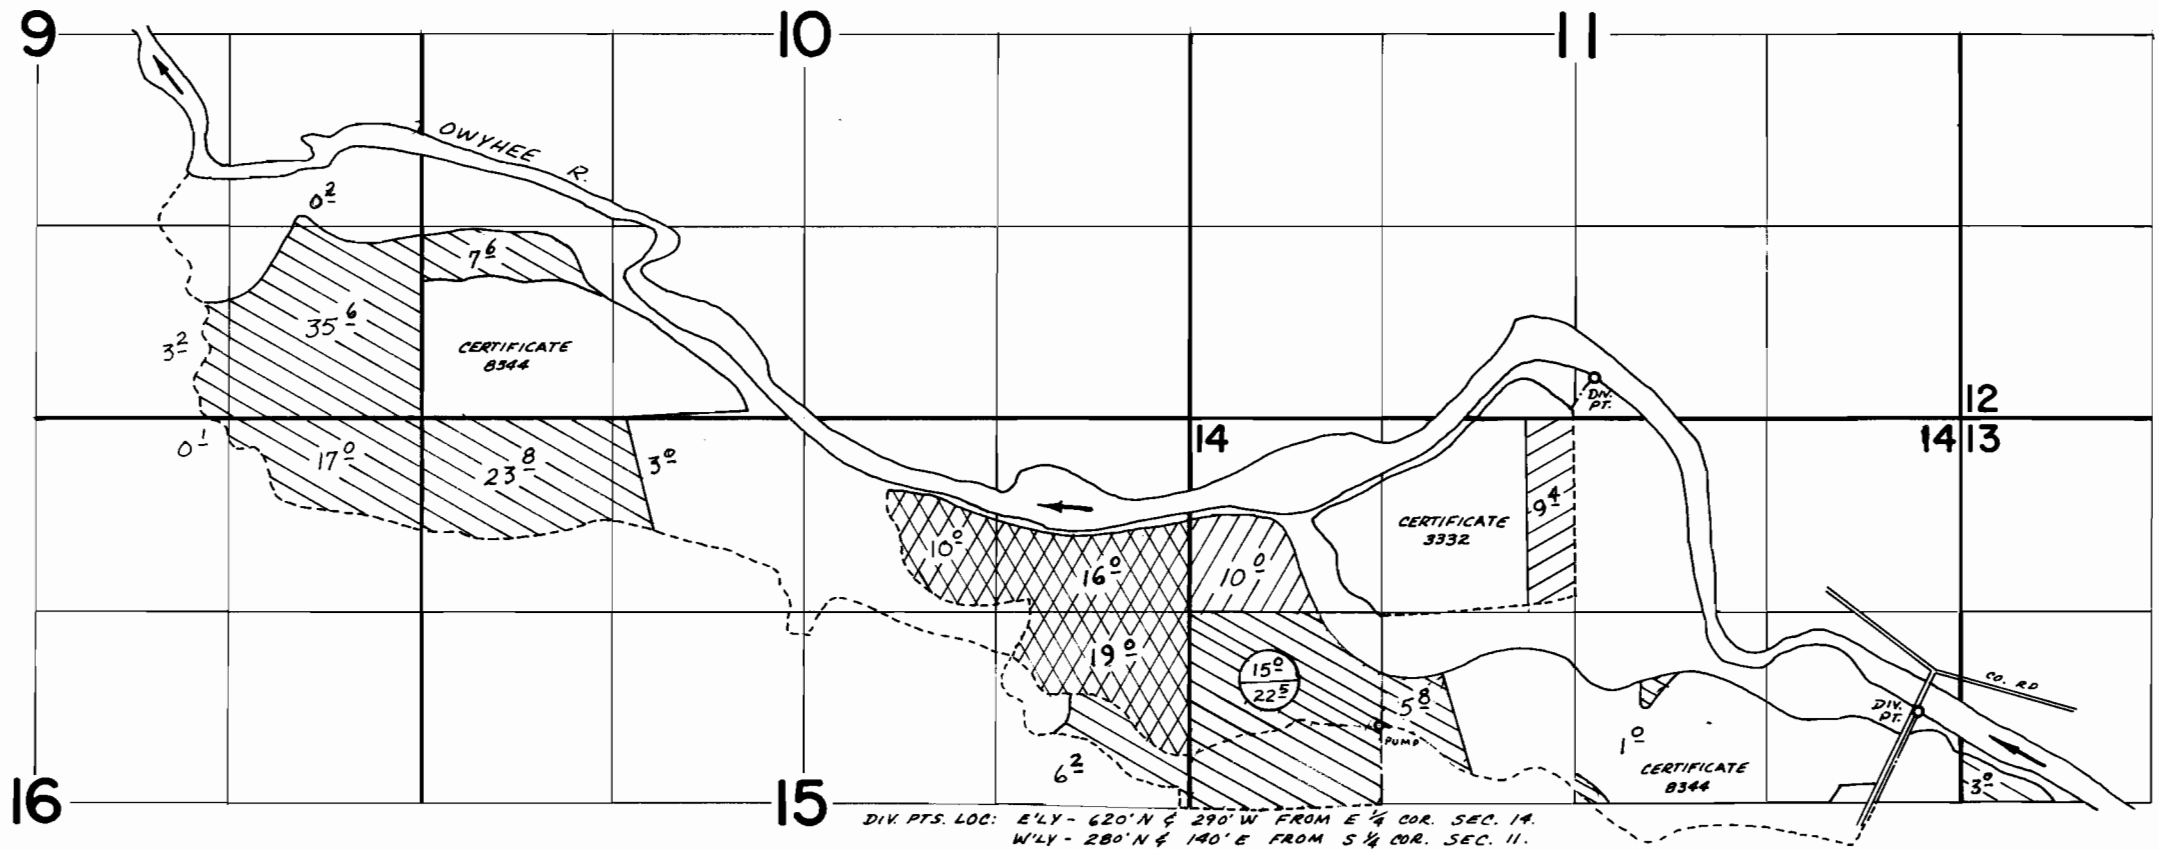

 APP- 43311

 APP- 43312

 APP- 43313

OLD RIGHT
PERMIT 36109

FINAL PROOF SURVEY

UNDER

Application No. 43311	Permit No. 36107
43312	36108
43313	36109

Transfer No. D-124
IN NAME OF

ROBERT DOWELL

Surveyed: July 14, 1975, by: D. Norby